

WASH.
M 63
3-27-75

MISSISSIPPI
BOARD OF WATER COMMISSIONERS
416 North State Street
Jackson, Mississippi 39201

WATER WELL DRILLERS LOG

CODED

March 27, 1975 Singer-Layne Central Div. Washington
date well completed firm name county well located


LANDOWNER: <u>W. A. Percy</u>	description of formations encountered	from	to
P. O. Box 97 Arcola, MS (mailing address)			
WELL LOCATION: sec. <u>2</u> T. <u>16</u> N R. <u>6</u> W <u>7</u> miles <u>east</u> of <u>Arcola</u> (distance) (direction) (nearest town)	Clay	0	7
	Brown Sand	7	29
	Coarse Sand	29	38
	Coarse Sand & Pea Gravel	38	59
	Coarse Sand & Gravel	59	65
	Coarse Sand & Pea Gravel	65	102
WELL PURPOSE: <u>irrigation</u> (home, irrigation, municipal, industrial)			
WELL COMPLETION DATA: (1) diameter (inches) <u>16"</u>			
(2) total depth (feet) <u>102'</u>			
(3) static water level (feet) <u>10</u> <u>below</u> top of ground. <u>above</u>			
(4) casing <u>steel</u> <u>62'</u> (material) (depth) <u>16"</u> If telescope see back. (size)			
(5) screen <u>40'</u> <u>62'</u> (length) (depth to top) <u>16"</u> <u>steel</u> (size) (material)			
(6) pump <u>40</u> <u>2000</u> (HP) (yield gpm) <u>electric</u> (type power)			
(7) electric log <u>no</u> (yes or no)			
(organization running log)			
(8) how well bottom plugged <u>with plate</u>			
DRILLERS REMARKS:			

DRILLERS LOG
MAY 10 1975

MISS. DR.

If well telescopes please sketch and show depths.

GROUND LEVEL

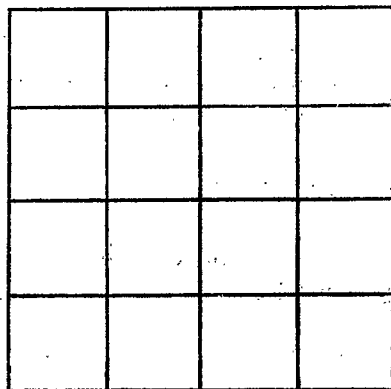

SECTION _____

Please indicate well location X.

ADDITIONAL INFORMATION

If more than one screen, show locations of each on sketch.