

WASHINGTON

CL-1121

M64

3-20-79

MISSISSIPPI BOARD OF WATER COMMISSIONERS
416 North State Street
Jackson, Mississippi 39201

CODED

WATER WELL DRILLERS LOG

March 20, 1979 Layne Central Company Washington

date well completed

firm name

county well located

LANDOWNER:

Joseph Theunissen

Hollandale, MS

(mailing address)

WELL LOCATION:

25 16 6
sec. T N R E
S W
4 miles NW of Hollandale
(distance) (direction) (nearest town)

WELL PURPOSE: irrigation
(home, irrigation, municipal, industrial)

WELL COMPLETION DATA:

- (1) diameter (inches) 16"
- (2) total depth (feet) 109'
- (3) static water level (feet) 20' ^{below} above top of ground.
- (4) casing Steel 59' (material) (depth)
16" If telescope see back. (size)
- (5) screen 50' 59' (length) (depth to top)
16" Stainless Steel (size) (material)
- (6) pump 60 2500 (HP) (yield gpm)
Diesel (type power)
- (7) electric log No (yes or no)

(organization running log)

(8) how well bottom plugged St Plate

DRILLERS REMARKS:

description of formations encountered

from

to

Clay	0	19
Sand	19	35
Coarse Sand & Pea		
Gravel	35	70
Big Gravel	70	109
Fine White Sand	109	111

CODED


Miss. Board of Water Comm.

SEP 12 1979

RECEIVED

If well telescopes please sketch and show depths.

GROUND LEVEL

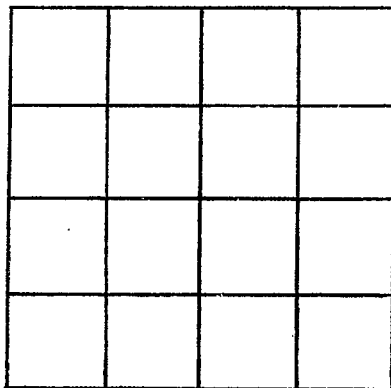

SECTION _____

Please indicate well location X.

ADDITIONAL INFORMATION

If more than one screen, show locations of each on sketch.