

WASHINGTON

M 66

4-25-77

MISSISSIPPI BOARD OF WATER COMMISSIONERS
416 North State Street
Jackson, Mississippi 39201

CODED

WATER WELL DRILLERS LOG

4-25 date well completed

1977 Bailey Dlg Co. firm name

Washington county well located

LANDOWNER: Vick + Ingram

Hollandale, MS

description of formations encountered

from to

Clay	0	18
Sand	18	65
Gravel	65	135
Mud	135	200
Mud + Sand	200	260
Mud	260	280
Sand	280	358

(mailing address)

WELL LOCATION:

sec. 32 T 16 N R 6 E S W
2 miles N of Hollandale
(distance) (direction) (nearest town)

WELL PURPOSE: Farm
(home, irrigation, municipal, industrial)

WELL COMPLETION DATA:

- (1) diameter (inches) 4 x 2 1/2 x 2
- (2) total depth (feet) 358
- (3) static water level (feet) 25 below top of ground.
- (4) casing Steel (material) (depth)
- 4 x 2 1/2 (size) If telescope see back.
- (5) screen 20' (length) 338' (depth to top)
- 2" (size) Stainless Steel (material)
- (6) pump 3 (HP) 50 (yield gpm)
- Elec (type power)
- (7) electric log No (yes or no)

(organization running log)

(8) how well bottom plugged
Back pressure valve

DRILLERS REMARKS:


CODED

RECEIVED
MAY 2 1977

MISS. BD. OF WATER COMMISSIONERS

If well telescopes please
sketch and show depths.

GROUND LEVEL

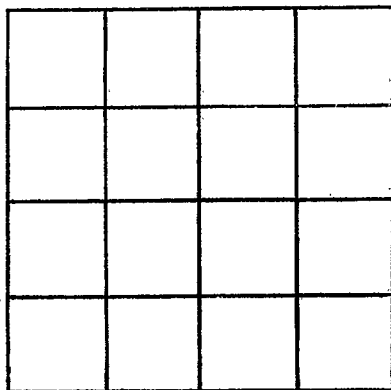

SECTION _____

Please indicate well location X.

ADDITIONAL INFORMATION

If more than one screen,
show locations of each on sketch.