

WASHINGTON
 CL-0739
 M 68
 3-18-78

MISSISSIPPI
 BOARD OF WATER COMMISSIONERS
 416 North State Street
 Jackson, Mississippi 39201

CODED

WATER WELL DRILLERS LOG

3-18 19 78 LAYNE CENTRAL CO. WASHINGTON
 date well completed firm name county well located

LANDOWNER:	description of fomations encountered	from	to
Davis & Davis Farms			
Hollandale, MS (mailing address)	Sand	20	40
WELL LOCATION: sec. 10 T 16 N R 6 W (distance) miles (direction) of (nearest town)	Coarse Sand-Pea Gr.	40	75
	Gravel	75	100
	Gravel w/clay	100	103
	Gravel	103	122
	WELL PURPOSE: Irrigation (home, irrigation, municipal, industrial)		
WELL COMPLETION DATA:			
(1) diameter (inches) 16"			
(2) total depth (feet) 122'			
(3) static water level (feet) 19 below top of ground.			
(4) casing Steel 72' (material) (depth) 16" (size) if telescope see back.			
(5) screen 50' 72' (length) (depth to top) 12" St. Steel (size) (material)			
(6) pump 60 2500 (HP) (yield.gpm) diesel (type power)			
(7) electric log no (yes or no)			
(organization running log)			
(8) how well bottom plugged St. Plate			
DRILLERS REMARKS:			

CODED


RECEIVED
 MISSISSIPPI
 BOARD OF WATER COMMISSIONERS

OCT 5 1978

MISS. BD. OF WATER COMMISSIONERS

If well telescopes please sketch and show depths.

GROUND LEVEL

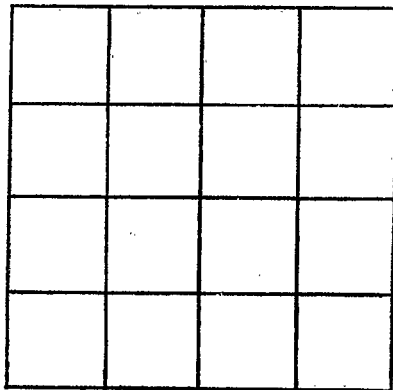

SECTION _____

Please indicate well location X.

ADDITIONAL INFORMATION

If more than one screen,
show locations of each on sketch.