

WASA
 CL-0827 M69
 4-4-78

MISSISSIPPI
 BOARD OF WATER COMMISSIONERS
 416 North State Street
 Jackson, Mississippi 39201

CODED

WATER WELL DRILLERS LOG

4-4 1978 LAYNE CENTRAL CO. WASHINGTON
 date well completed firm name county well located

LANDOWNER: HARRY KEY FARMS
 HOLLANDALE, MS
 (mailing address)
 WELL LOCATION:
 sec. 26 T. 16 N R. 6 W
 3 miles NW HOLLANDALE
 (distance) (direction) (nearest town)

description of formations encountered	from	to
clay	0	8
red sand	8	25
fine sand	25	38
coarse sand	38	44
coarse sand & pea gravel	44	52
med. coarse sand	52	86
coarse sand	86	92
coarse sand & gravel	92	115
clay	115	117

WELL PURPOSE: Irrigation
 (home, irrigation, municipal, industrial)

WELL COMPLETION DATA:

(1) diameter (inches) 16"

(2) total depth (feet) 115'

(3) static water level (feet) 16' below top of ground.

(4) casing steel, 85' (material) (depth)
 16" if telescope see back. (size)

(5) screen 30' 85' (length) (depth to top)
 12" st. steel (size) (material)

(6) pump 60 2500 (HP) (yield gpm)
 diesel (type power)

(7) electric log no (yes or no)
 (organization running log)

(8) how well bottom plugged st. plate


RECORDED
 NOV 10 1978

DRILLERS REMARKS:

MISS. Bd. of WATER COMMISSIONERS

If well telescopes please sketch and show depths.

GROUND LEVEL

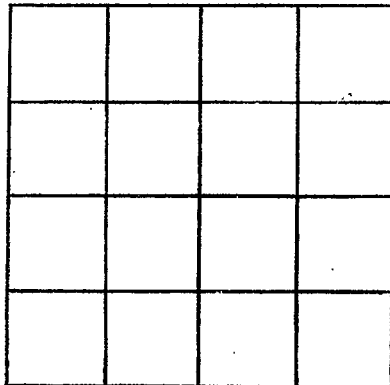

SECTION _____

Please indicate well location X.

ADDITIONAL INFORMATION

If more than one screen, show locations of each on sketch.