

WASHINGTON
MTO
7-10-79

MISSISSIPPI
BOARD OF WATER COMMISSIONERS
416 North State Street
Jackson, Mississippi 39201

CODED

WATER WELL DRILLERS LOG

7-10-1979 date well completed
Larry's Well Pump Co. firm name
Washington Co. county well located

LANDOWNER: Frances Busa
Leland Miss.

description of formations encountered	from	to
clay	0	20
coarse sand	20	42
coarse sand & gravel	42	57
coarse sand & rocks	57	73
coarse sand & gravel	73	105
coarse sand & wood	105	111

(mailing address)

WELL LOCATION:
sec. 21 T. 16 N. R. 5 E. S. 5 W.
9 East miles 3 North of Hattiesburg
(distance) (direction) (nearest town)

WELL PURPOSE:
(home, irrigation, municipal, industrial)

CODED

WELL COMPLETION DATA:

- (1) diameter (inches) 16"
- (2) total depth (feet) 106
- (3) static water level (feet) 22 below top of ground.
- (4) casing steel, 66' (material), (depth)
- (size) if telescope see back.
- (5) screen 40, 66' (length), (depth to top)
- 16", steel (size), (material)
- (6) pump 60, 3000 (HP), (yield gpm)
- 0 (type power)
- (7) electric log (yes or no)
- (organization running log)
- (8) how well bottom plugged steel plate

Miss. Board of Water Comm.


AUG 21 1979

DRILLERS REMARKS:

RECEIVED

If well telescopes please sketch and show depths.

GROUND LEVEL

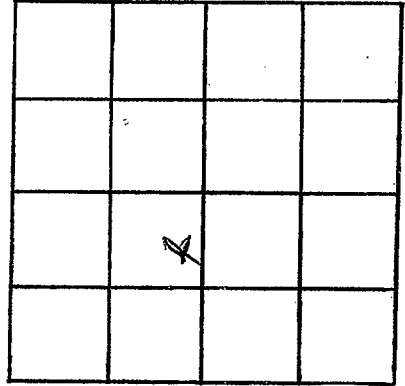

SECTION 21

Please indicate well location X.

ADDITIONAL INFORMATION

If more than one screen,
show locations of each on sketch.