

WASHINGTON

CL-1134 M 71

4-29-79

MISSISSIPPI BOARD OF WATER COMMISSIONERS
416 North State Street
Jackson, Mississippi 39201

CODED

WATER WELL DRILLERS LOG

April 29, 1979 Layne Central Company Washington
date well completed firm name county well located

LANDOWNER:

Theunissen
Joseph Theunissen

description of formations encountered

from to

Hollandale, MS
(mailing address)

Clay	0	10
Coarse Brown Sand	10	45
Coarse Sand & Pea		
Gravel	45	64
Coarse Sand & Gravel	64	117

WELL LOCATION:

sec. 25-16 N R 6 E
T S
4 miles NW of Hollandale
(distance) (direction) (nearest town)

CODED

WELL PURPOSE: irrigation
(home, irrigation, municipal, industrial)

WELL COMPLETION DATA:

- (1) diameter (inches) 16"
- (2) total depth (feet) 117'
- (3) static water level (feet) 22' below above top of ground.
- (4) casing Steel 67' (material) (depth)
16" (size) if telescope see back.
- (5) screen 50' 67' (length) (depth to top)
16" Stainless Steel (size) (material)
- (6) pump 60 2500 (HP) (yield gpm)
Diesel (type power)
- (7) electric log NO (yes or no)

(organization running log)

(8) how well bottom plugged St Plate

Miss. Board of Water Comm.


DRILLERS REMARKS:

SEP 12 1979

RECEIVED

If well telescopes please sketch and show depths.

GROUND LEVEL

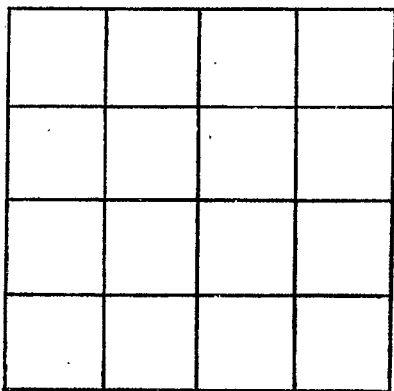

SECTION _____

Please indicate well location X.

ADDITIONAL INFORMATION

A series of horizontal lines for recording additional information, starting below the 'ADDITIONAL INFORMATION' header and extending to the bottom of the page.

If more than one screen, show locations of each on sketch.