

Washington
M-72
10-12-79

MISSISSIPPI
BOARD OF WATER COMMISSIONERS
416 North State Street
Jackson, Mississippi 39201

CODED

WATER WELL DRILLERS LOG

12-12-79 date well completed
1979 Long Well & Pump Co. firm name
Washington Co. county well located

LANDOWNER: FL Longly
Hollandale Miss
(mailing address)
WELL LOCATION:
sec. 20 T 16 N R 5 E
S W
2 E miles 1 S of Harlow
(distance) (direction) (nearest town)

description of formations encountered	from	to
clay	0'	19'
coarse sand	19'	125'
clay + sand	125'	160'
sand	160'	350'
clay + sand	350'	420'
sand	420'	467'

WELL PURPOSE:
(home, irrigation, municipal, industrial)

WELL COMPLETION DATA: 100' 4"

- (1) diameter (inches) 4 1/2"
- (2) total depth (feet) 467
- (3) static water level (feet) 20 below above top of ground.
- (4) casing steel 447'
(material) (depth)
(size) If telescope see back.
- (5) screen 20 447'
(length) (depth to top)
2" stainless steel
(size) (material)
- (6) pump 2 40
(HP) (yield gpm)
Electric
(type power)
- (7) electric log (yes or no)

(organization running log)

(8) how well bottom plugged Wash valve

DRILLERS REMARKS:

CODED


DEPT. OF NATURAL RESOURCES
BUREAU OF LAND & WATER RESOURCES

JAN 19 1980

RECEIVED

If well telescopes please sketch and show depths.

GROUND LEVEL

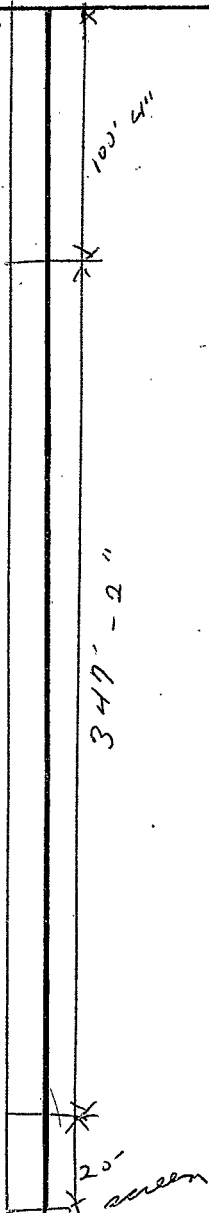

		x	

SECTION 20

Please indicate well location X.

ADDITIONAL INFORMATION

If more than one screen,
show locations of each on sketch.