

WASHINGTON
M 74
8-22-80

MISSISSIPPI DEPARTMENT OF NATURAL RESOURCES,
Bureau of Land and Water Resources
Southport Mall
P.O. Box 10631
Jackson, Mississippi 39209
WATER WELL DRILLERS LOG

CODED

8/22 1980 DYER WELL #1R2 WASHINGTON
date well completed firm name county well located

LANDOWNER:
ROSS UNDERWOOD
Box 55
ARCOLA, MISS 38722
(mailing address)

description of formations encountered	from	to
CLAY	0	23
SAND	23	43
SAND + GRAVEL	43	53
SAND	53	63
SAND + GRAVEL	63	93
GRAVEL	93	113

WELL LOCATION:
sec. 8 T. 16 N. R. 6 E
S W
1/2 miles SE of ARCOLA
(distance) (direction) (nearest town)

WELL PURPOSE:
(home, irrigation, municipal, industrial)

WELL COMPLETION DATA:

(1) diameter (inches) 16

(2) total depth (feet) 113

(3) static water level (feet) 18 below top of ground.

(4) casing STEEL 73
(material) (depth)
16" if telescope see back.
(size)

(5) screen 40 73
(length) (depth to top)
16 STEEL
(size) (material)

(6) pump 60 3000
(HP) (yield gpm).

ELECTRIC
(type power)

(7) electric log NO.
(yes or no)

(organization running log)

(8) how well bottom plugged STEEL PLATE


CODED

DEPT. OF NATURAL RESOURCES
BUREAU OF LAND & WATER RESOURCES
OCT - 1 1980
RECEIVED

DRILLERS REMARKS:

If well telescopes please sketch and show depths.

GROUND LEVEL

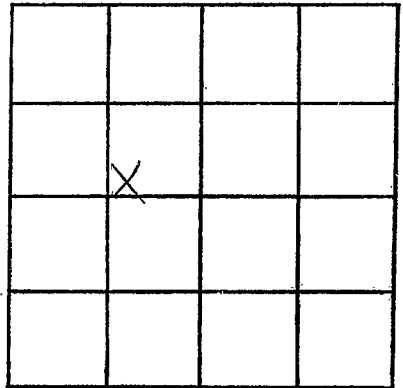

SECTION 8

Please indicate well location X.

ADDITIONAL INFORMATION

If more than one screen, show locations of each on sketch.