


Washington  
M 75  
  
11/20/80  
Nov. 20. 19 80

MISSISSIPPI  
BOARD OF WATER COMMISSIONERS  
416 North State Street  
Jackson, Mississippi 39201

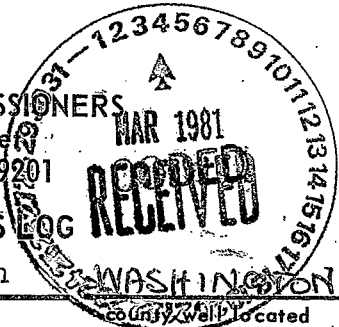

WATER WELL DRILLERS LOG

Nov. 20. 19 80 Bruce Berryman

date well completed firm name  
Greenwood.

LANDOWNER: Mr/ Pickett Myers.		description of formations encountered	from	to
Kinlock Plantation				
Rt. 1. Indianola. MS 3875		Sand	20	80
(mailing address)		Sand & Gravel	80	180
		Clay	180	240
WELL LOCATION:		Sandy shale	240	300
sec. 8 T 16 N R 5 E		Sand	300	320
7 miles W of ARCOLA		Sandy shale	320	340
(distance) (direction) (nearest town)		Fine sand	340	440
WELL PURPOSE: HOME		Shale	440	460
(home, irrigation, municipal, industrial)		Sand & str. shale	460	520
WELL COMPLETION DATA:		Sand	520	535
(1) diameter (inches) 4" x 2"		Clay	535	560
(2) total depth (feet) 650'		Shale	560	630
(3) static water level (255) 23' below top of ground		Sand	630	650
(4) casing 4" blk. - 126'		Clay	650	660
(material) (depth)				
if telescope see back.				
(size)				
(5) screen 20' / 630'				
(length) (depth to top)				
.010, Stainless steel				
(size) (material)				
(6) pump 1 1/2 h.p. 30				
(HP) (yield gpm)				
Electric				
(type power)				
(7) electric log NO				
(yes or no)				
(organization running log)				
(8) how well bottom plugged B.P.V				
DRILLERS REMARKS:				

DEPT. OF NATURAL RESOURCES  
BUREAU OF LAND & WATER RESOURCES

MAR - 4 1981  
RECEIVED

If well telescopes please sketch and show depths.

GROUND LEVEL

			X

SECTION 8

Please indicate well location X.

ADDITIONAL INFORMATION

If more than one screen, show locations of each on sketch.