

Washington  
M-78  
12-17-80

Bureau of Land and Water Resources  
Southport Mall  
P.O. Box 10631  
Jackson, Mississippi 39209  
WATER WELL DRILLERS LOG

3384

12/17/1980 date well completed  
Dyer firm name  
Wash. county well located

LANDOWNER:  
TRAIL LAKE

description of formation encountered  
CODED from to

(mailing address)

0-30' Gravelly Clay  
30-83 Fine Sand

WELL LOCATION:  
sec. 11 T. 160 N. S. R. 6 E. W. Trail Lake  
(distance) (direction) (nearest town)


83-103' Gravel  
103-113' Big Rock Gravel

WELL PURPOSE:  
(home, irrigation, municipal, industrial)


WELL COMPLETION DATA:

- (1) diameter (inches) 16"
- (2) total depth (feet) 113'
- (3) static water level (feet) 22' below top of ground.
- (4) casing Steel 113' (material) (depth)  
16" if telescope see back. (size)
- (5) screen 40' 73' (length) (depth to top)  
16" steel (size) (material)
- (6) pump 60 3000 (HP) (yield gpm)  
electric (type power)
- (7) electric log (yes or no)  
(organization running log)
- (8) how well bottom plugged flats

CODED

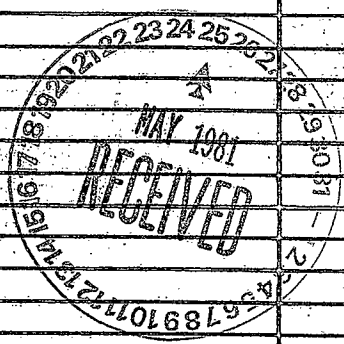

DRILLERS REMARKS:

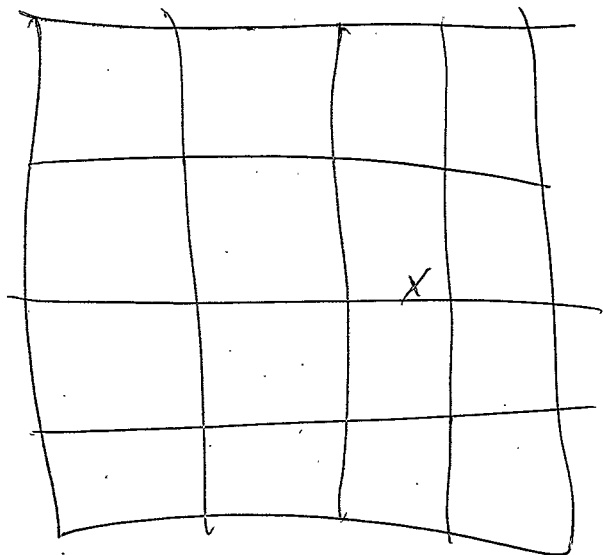

Sec 11