

Washington
M 79
12-19-80

Bureau of Land and Water Resources
Southport Mall
P.O. Box 10631

Jackson, Mississippi 39209
WATER WELL DRILLERS LOG

12/19/80 date well completed
Dyer firm name
Wash. county well located

LANDOWNER:
TRAILAKE #2
(mailing address)

description of formations encountered	CODED	
	from	to
Clay	6	18
fine sand	12	20
sand	28	38
sand + gravel	48	60
sand	60	75
sand + gravel	75	108
		110

WELL LOCATION:
sec. 11 T. 16 N. R. 6 E. S. 1 W.
miles (distance) of (direction) of (nearest town)

WELL PURPOSE:
(home, irrigation, municipal, industrial)

WELL COMPLETION DATA:

(1) diameter (inches) 16"

(2) total depth (feet) 110'

(3) static water level (feet) 22' below top of ground.

(4) casing Steel 110' (material) (depth)

16" if telescope see back. (size)

(5) screen 40' 70' (length) (depth to top)

16" steel (size) (material)

(6) pump 60 3000 (HP) (yield gpm)


electric (type power)

(7) electric log (yes or no)


(organization running log)

(8) how well bottom plugged plate

CODED

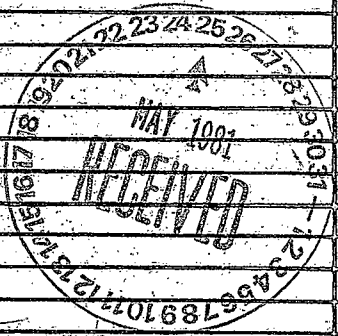

DRILLERS REMARKS:

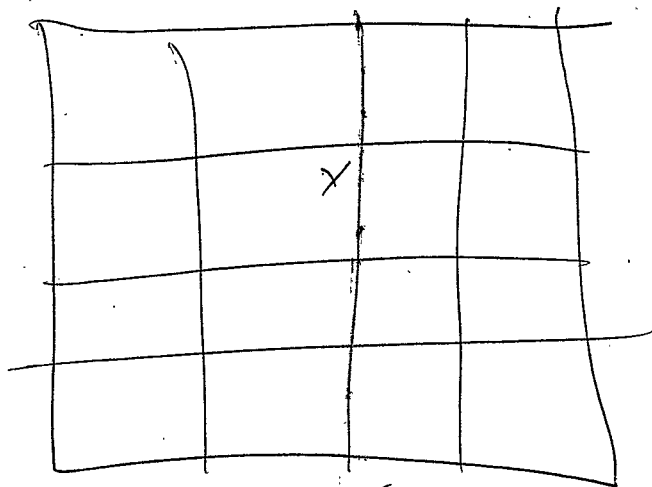

Sec 41