

MISSISSIPPI DEPARTMENT OF NATURAL RESOURCES

Bureau of Land and Water Resources

Southport Mall

P.O. Box 10631

Jackson, Mississippi 39209

WATER WELL DRILLERS LOG

Washington
M#86
5-12-81


May 12 1981 date well completed
 Larry's Well & pump firm name
 Washington county well located

LANDOWNER: <u>Ricky McCorkle</u>	description of formations encountered	CODED	from	to
<u>Hollandale, Miss</u> (mailing address)	<u>Clay</u>		<u>0</u>	<u>30</u>
	<u>Five Sand</u>		<u>30</u>	<u>70</u>
	<u>Coarse Sand</u>		<u>70</u>	<u>116</u>
WELL LOCATION:				
sec. <u>36</u> T. <u>16</u> N. R. <u>6</u> E				
<u>5</u> miles <u>E</u> of <u>Hollandale</u>				
(distance) (direction) (nearest town)				
WELL PURPOSE: (home, irrigation, municipal, industrial)				
WELL COMPLETION DATA:				
(1) diameter (inches) <u>16"</u>				
(2) total depth (feet) <u>116'</u>				
(3) static water level (feet) <u>24'</u> below above top of ground.				
(4) casing <u>Steel</u> , <u>76'</u> (material) (depth)				
(size) If telescope see back.				
(5) screen <u>40'</u> , <u>76'</u> (length) (depth to top)				
<u>16"</u> , <u>Steel</u> (size) (material)				
(6) pump _____ (HP) _____ (yield gpm)				
(type power)				
(7) electric log <u>No</u> (yes or no)				
(organization running log)				
(8) how well bottom plugged <u>Steel Plate</u>				
DRILLERS REMARKS:				

DEPT. OF NATURAL RESOURCES
 BUREAU OF LAND & WATER RESOURCES
 JUN 16 1981
RECEIVED

If well telescopes please sketch and show depths.

GROUND LEVEL

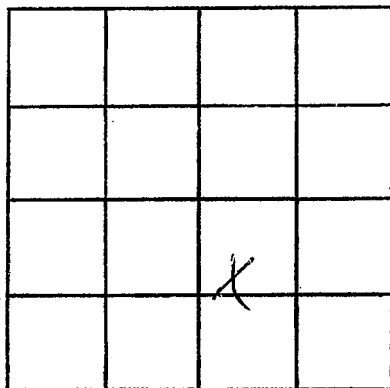

SECTION 36

Please indicate well location X.

ADDITIONAL INFORMATION

If more than one screen, show locations of each on sketch.