

MISSISSIPPI DEPARTMENT OF NATURAL RESOURCES
 Bureau of Land and Water Resources
 Southport Mall
 P.O. Box 10631
 Jackson, Mississippi 39209
WATER WELL DRILLERS LOG

CODED

Washington
M 88
3/11/82

3/11 1982 Leary's well & pump Washington
 date/well completed film name county well located

LANDOWNER: Billy Harris

description of formations encountered

from

to

Hollandale MS
 (mailing address)

clay 0 30
med sand 30 50
course sand 50 98

WELL LOCATION:

sec. 25 T. 16 N R. 6 E
 S W

5 East miles 1 North of Hollandale
 (distance) (direction) (nearest town)

WELL PURPOSE:

(home, irrigation, municipal, industrial)

CODED

WELL COMPLETION DATA:

- (1) diameter (inches) 8"
- (2) total depth (feet) 98'
- (3) static water level (feet) 23' below above top of ground.
- (4) casing PVC, 58'
 (material) (depth)

 if telescope see back.
 (size)

- (5) screen 40', 58'
 (length) (depth to top)

8", PVC
 (size) (material)

- (6) pump 10 H.P., 700
 (HP) (yield gpm)

Elec.
 (type power)

- (7) electric log NO
 (yes or no)

 (organization running log)

- (8) how well bottom plugged PVC cap

DRILLERS REMARKS:


DEPT. OF NATURAL RESOURCES
 BUREAU OF LAND & WATER RESOURCES

JUN 21 1982

RECEIVED

If well telescopes please sketch and show depths.

GROUND LEVEL

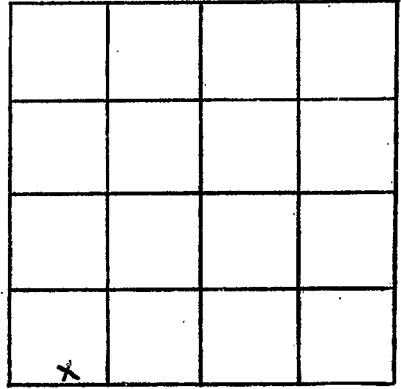

SECTION 25

Please indicate well location X.

ADDITIONAL INFORMATION

If more than one screen, show locations of each on sketch.