

MISSISSIPPI DEPARTMENT OF NATURAL RESOURCES

Bureau of Land and Water Resources

Southport Mall

P.O. Box 10631

Jackson, Mississippi 39209

WATER WELL DRILLERS LOG

CODED

Washington
M 90
5182

date well completed 19 Aug well name Dyer Well county well located Washington

LANDOWNER:	Description of formations encountered	from	to
<u>Boas Underwood</u>			
<u>Arcola, Miss</u>			
(mailing address)			
WELL LOCATION:			
sec. <u>9</u> T. <u>16</u> N. R. <u>6</u> E.			
<u>5</u> miles <u>SE.</u> of <u>Arcola</u>			
(distance) (direction) of (nearest town)			
WELL PURPOSE:			
(home, irrigation, municipal, industrial)			
WELL COMPLETION DATA:			
(1) diameter (inches) <u>16</u>			
(2) total depth (feet) <u>73</u>			
(3) static water level (feet) <u>22</u> below above top of ground			
(4) casing <u>Steel</u> <u>73</u> (material) (depth)			
(size) If telescope see back.			
(5) screen <u>40'</u> <u>40'</u> (length) (depth to top)			
<u>16"</u> <u>steel</u> (size) (material)			
(6) pump <u>60</u> <u>3000</u> (HP) (yield gpm)			
<u>electric</u> (type power)			
(7) electric log <u>no</u> (yes or no)			
<u>no</u> (organization running log)			
(8) how well bottom plugged <u>plate</u>			
DRILLERS REMARKS:			

Clay 0 25
 Fine Sand 25 40
 Sand & Gravel 40 113

CODED


DEPT. OF NATURAL RESOURCES
 BUREAU OF LAND & WATER RESOURCES

FEB - 8 1983

RECEIVED

If well telescopes please sketch and show depths.

GROUND LEVEL

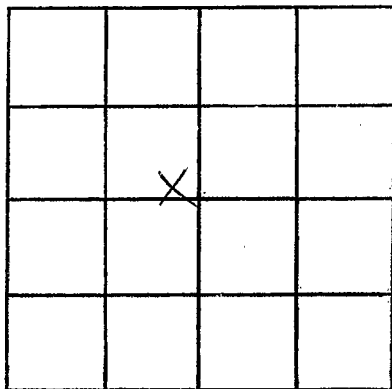

SECTION 9

Please indicate well location X.

ADDITIONAL INFORMATION

If more than one screen, show locations of each on sketch.