

MISSISSIPPI DEPARTMENT OF NATURAL RESOURCES

Bureau of Land and Water Resources

Southport Mall

P.O. Box 10631

Jackson, Mississippi 39209 **CODED**

WATER WELL DRILLERS LOG

M91

4-30-83

April 30 1983 Larry's Well & Pump firm name Washington Co. county well located

LANDOWNER: <u>Johnny McCollum</u>	description of formations encountered	from	to
<u>Hollandale Ms.</u> (mailing address)	<u>Clay</u> <u>Silt</u> <u>Sand &amp; gravel</u>	<u>0</u> <u>30</u> <u>50</u>	<u>30</u> <u>50</u> <u>115'</u>
<b>WELL LOCATION:</b> sec. <u>34</u> T. <u>16</u> N R. <u>—</u> E S <u>5</u> W <u>1.8</u> miles <u>East</u> of <u>Hollandale</u> (distance) (direction) (nearest town)			
<b>WELL PURPOSE:</b> (home, irrigation, municipal, industrial)			
<b>WELL COMPLETION DATA:</b>			
(1) diameter (inches) <u>12"</u>			
(2) total depth (feet) <u>115'</u>			
(3) static water level (feet) <u>22</u> <u>below</u> <u>above</u> top of ground.			
(4) casing <u>Steel</u> , <u>75'</u> (material) (depth) <u>—</u> if telescope see back. (size)			
(5) screen <u>40'</u> , <u>75'</u> (length) (depth to top) <u>12"</u> , <u>steel</u> (size) (material)			
(6) pump <u>40</u> , <u>2000</u> (HP) (yield gpm) <u>b</u> (type power)			
(7) electric log <u>No.</u> (yes or no) <u>—</u> (organization running log)			
(8) how well bottom plugged <u>Steel</u> <u>Plate</u>			
DRILLERS REMARKS: <u>—</u>			

**CODED**


DEPT. OF NATURAL RESOURCES  
BUREAU OF LAND & WATER RESOURCES

SEP 26 1983

RECEIVED

If well telescopes please  
sketch and show depths.

GROUND LEVEL

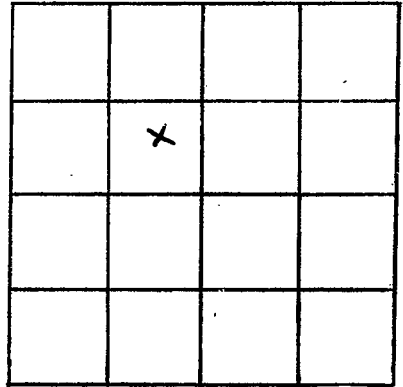

SECTION 34

Please indicate well location X.

ADDITIONAL INFORMATION

If more than one screen,  
show locations of each on sketch.