

MISSISSIPPI DEPARTMENT OF NATURAL RESOURCES

Bureau of Land and Water Resources

Southport Mall

P.O. Box 10631

Jackson, Mississippi 39209

WATER WELL DRILLERS LOG

CODED

WASHINGTON  
M 92  
8/5/83

Aug 5, 1983 date well completed  
Dyer Well + Irrigation firm name  
Washington county well located

LANDOWNER: <u>Donald Rowe</u>	description of formations encountered	from	to
<u>Hollandale, Miss.</u> (mailing address)	<u>Clay</u>	<u>0</u>	<u>25</u>
WELL LOCATION:	<u>fine sand</u>	<u>25</u>	<u>48</u>
sec. <u>20</u> T. <u>16</u> (N) R. <u>6</u> E	<u>sand</u>	<u>48</u>	<u>60</u>
<u>2</u> miles <u>East</u> of <u>Estill</u>	<u>sand + gravel</u>	<u>60</u>	<u>85</u>
(distance) (direction) (nearest town)	<u>fine sand</u>	<u>85</u>	<u>122</u>
WELL PURPOSE: <u>irrigation</u> (home, irrigation, municipal, industrial)	<u>sand + gravel</u>	<u>92</u>	<u>122</u>
WELL COMPLETION DATA:	CODED		
(1) diameter (inches) <u>16</u>			
(2) total depth (feet) <u>120'</u>			
(3) static water level (feet) <u>24'</u> below top of ground.			
(4) casing <u>Steel</u> , <u>80'</u> (material) (depth)			
<u>16</u> if telescope see back. (size)			
(5) screen <u>40</u> , <u>80'</u> (length) (depth to top)			
<u>16</u> , <u>Mild Steel</u> (size) (material)			
(6) pump <u>600</u> , <u>3,000</u> (HP) (yield gpm)			
<u>Electric</u> (type power)			
(7) electric log <u>No</u> (yes or no)			
(organization running log)			
(8) how well bottom plugged <u>Plate</u>			
DRILLERS REMARKS:			

DEPT. OF NATURAL RESOURCES  
BUREAU OF LAND & WATER RESOURCES


DEC - 7 1983

RECEIVED

Mike Brucherberg

If well telescopes please sketch and show depths.

GROUND LEVEL

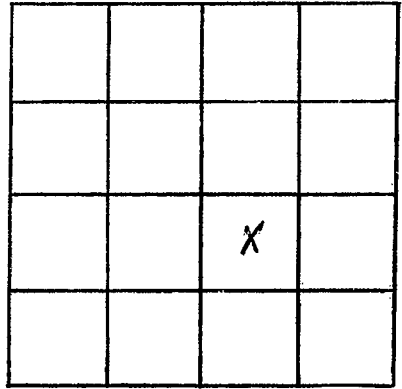

SECTION 20

Please indicate well location X.

ADDITIONAL INFORMATION

If more than one screen,  
show locations of each on sketch.