

**MISSISSIPPI DEPARTMENT OF NATURAL RESOURCES**  
**Bureau of Land and Water Resources**  
 Southport Mall  
 P.O. Box 10631 **CODED**  
 Jackson, Mississippi 39209  
**WATER WELL DRILLERS LOG**

M 93  
 EI-2708 WASHINGTON  
 4-16-84

4/16 19 84 LAYNE CENTRAL CO. WASHINGTON  
 date well completed firm name county well located

**LANDOWNER:**  
 SHACKLEFORD FARMS  
 HOLLANDALE, MS  
 (mailing address)

description of formations encountered	from	to
clay	0	25
sand	25	38
pea gravel	38	80
gravel	80	120
sand	120	123

**WELL LOCATION:**  
 sec. 32 T 16 N R 6 W  
 1/2 miles SW of HOLLANDALE  
 (distance) (direction) (nearest town)

**WELL PURPOSE:** irrigation  
 (home, irrigation, municipal, industrial)

**WELL COMPLETION DATA:**

- (1) diameter (inches) 32"
- (2) total depth (feet) 120'
- (3) static water level (feet) 19' below top of ground.
- (4) casing steel 70' (material) (depth)  
 16" (size) if telescope see back.
- (5) screen 50' 70' (length) (depth to top)  
 16" st. stee. (size) (material)
- (6) pump 60 2500 (HP) (yield gpm)  
 diesel (type power)
- (7) electric log no (yes or no)  
 (organization running log) st: plate
- (8) how well bottom plugged

**DRILLERS REMARKS:**


DEPT. OF NATURAL RESOURCES  
 BUREAU OF LAND & WATER RESOURCES

MAY 25 1984

**RECEIVED**

If well telescopes please sketch and show depths.

GROUND LEVEL

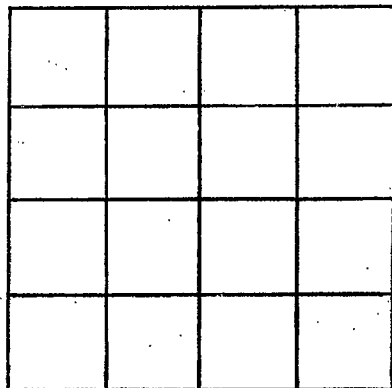

SECTION \_\_\_\_\_

Please indicate well location X.

ADDITIONAL INFORMATION

If more than one screen,  
show locations of each on sketch.