

WASHINGTON
M 94

MISSISSIPPI DEPARTMENT OF NATURAL RESOURCES
Bureau of Land and Water Resources
Southport Mall
P.O. Box 10631
Jackson, Mississippi 39209
WATER WELL DRILLERS LOG

CODED

6-7 1984 date well completed Schultz Drilling firm name Washington county well located

LANDOWNER:
Julian Potter
ARCOLA, MS
(mailing address)

description of formations encountered	from	to
	Clay	0
SAND	12	40
SAND + gravel	40	60
GRAVEL	60	70

WELL LOCATION:
sec. 36 T. 16 N. R. 6 E
3 miles SE of ARCOLA
(distance) (direction) (nearest town)

WELL PURPOSE: IRRIGATION
(home, irrigation, municipal, industrial)

CODED

- WELL COMPLETION DATA:
- (1) diameter (inches) 12"
 - (2) total depth (feet) 90'
 - (3) static water level (feet) 18' below top of ground.
 - (4) casing PVC 50' (material) (depth)
 - (size) if telescope see back.
 - (5) screen 40' 50' (length) (depth to top)
 - 12" PVC (size) (material)
 - (6) pump 30 1500 (HP) (yield gpm)
 - gear (type power)
 - (7) electric log NO (yes or no)
 - NO (organization running log)
 - (8) how well bottom plugged PVC CAP

DRILLERS REMARKS:
M


DEPT. OF NATURAL RESOURCES
BUREAU OF LAND & WATER RESOURCES

JUN 25 1984

RECEIVED

If well telescopes please sketch and show depths.

GROUND LEVEL

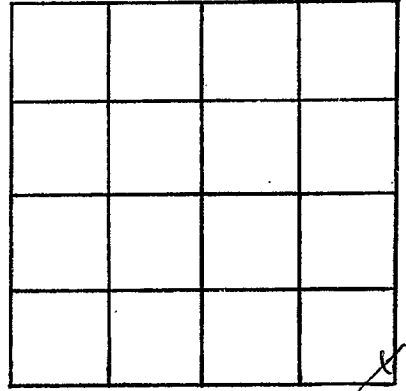

SECTION 36

Please indicate well location X.

ADDITIONAL INFORMATION

If more than one screen, show locations of each on sketch.