

MISSISSIPPI DEPARTMENT OF NATURAL RESOURCES

Bureau of Land and Water Resources

Southport Mall

P.O. Box 10631

Jackson, Mississippi 39209

WATER WELL DRILLERS LOG

CODED

WASHINGTON
M. 95

April 11, 1984
date well completed

Larry's Well & Pump
firm name

Washington
county well located

LANDOWNER: Jerry Miller

description of formations encountered

from to

Hollendale Ms
(mailing address)

| | | |
|-------------|----|-----|
| slay | 0 | 30 |
| Fine Sand | 30 | 50 |
| course Sand | 50 | 100 |

WELL LOCATION:

sec 26 T 16 N
S R 6 W
2 miles S of Darlowe
(distance) (direction) (nearest town)

WELL PURPOSE:
(home, irrigation, municipal, industrial)

WELL COMPLETION DATA:

- (1) diameter (inches) 8"
- (2) total depth (feet) 100'
- (3) static water level (feet) 24 ^{below} ~~above~~ top of ground.
- (4) casing PVC 60'
(material) (depth)
- (size) If telescope see back.
- (5) screen 40' 60'
(length) (depth to top)
- 8" PVC
(size) (material)
- (6) pump 20 1100
(HP) (yield gpm)
- E
(type power)
- (7) electric log NO
(yes or no)

(organization running log)

(8) how well bottom plugged PVC
CAP

DRILLERS REMARKS:

CODED


DEPT. OF NATURAL RESOURCES
BUREAU OF LAND & WATER RESOURCES

AUG 31 1984

RECEIVED

If well telescopes please sketch and show depths.

GROUND LEVEL

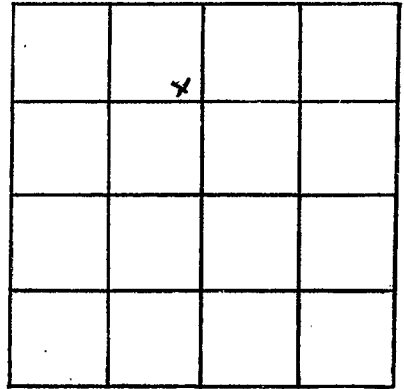

SECTION ~~33~~ 26

Please indicate well location X.

ADDITIONAL INFORMATION

If more than one screen, show locations of each on sketch.