

MISSISSIPPI DEPARTMENT OF NATURAL RESOURCES

Bureau of Land and Water Resources

Southport Mall

P.O. Box 10631

Jackson, Mississippi 39209

WATER WELL DRILLERS LOG

CODED

WASHINGTON

M 96

April 12 1984  
date well completed

Larry's well pump  
firm name

Washington  
county well located

LANDOWNER: Jerry Miller

description of formations encountered

from

to

Hollandale Ms.  
(mailing address)

slay	0	30
Fine Sand	30	50
coarse sand	50	100

WELL LOCATION:

seq. 30 T 16 N R E  
S 2-5 S W  
2 miles East of Danlove  
(distance) (direction) (nearest town)

WELL PURPOSE:  
(home, irrigation, municipal, industrial)

WELL COMPLETION DATA:

- (1) diameter (inches) 8"
- (2) total depth (feet) 100'
- (3) static water level (feet) 22' below top of ground.
- (4) casing PVC, 60' (material) (depth)
- (size) If telescope see back.
- (5) screen 40' 60' (length) (depth to top)
- 8" PVC (size) (material)
- (6) pump 20 1100 (HP) (yield gpm)
- E (type power)
- (7) electric log NO (yes or no)

CODED

(organization running log)

(8) how well bottom plugged PVC cap

DRILLERS REMARKS:


DEPT. OF NATURAL RESOURCES  
BUREAU OF LAND & WATER RESOURCES

AUG 31 1984

RECEIVED

If well telescopes please sketch and show depths.

GROUND LEVEL

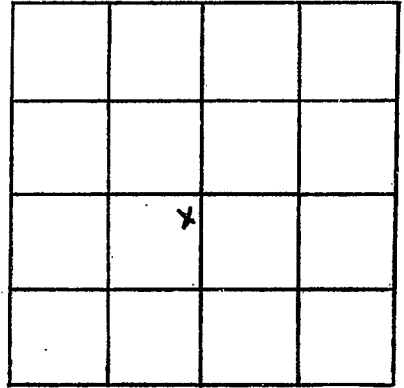

SECTION 30

Please indicate well location X.

ADDITIONAL INFORMATION

If more than one screen,  
show locations of each on sketch.