

MISSISSIPPI DEPARTMENT OF NATURAL RESOURCES

Bureau of Land and Water Resources

Southport Mall

P.O. Box 10631

Jackson, Mississippi 39209

WATER WELL DRILLERS LOG

CODED

WASHINGTON

M 98

April 12 19 84 Larry's well v pump Washington
 date well completed firm name county well located

LANDOWNER: Jerry Miller

Hollandale mo
 (mailing address)

description of formations encountered

from to

clay 0 80
 water sand & gravel 80 128

WELL LOCATION:

sec. 18 T. 16 N R. E
 S W
 1/2 miles East of Darlove
 (distance) (direction) (nearest town)

CODED

WELL PURPOSE:

(home, irrigation, municipal, industrial)

WELL COMPLETION DATA:

- (1) diameter (inches) 8"
- (2) total depth (feet) 128'
- (3) static water level (feet) 22' below top of ground.
- (4) casing PVC, 88' (material) (depth)
 (size) If telescope see back.
- (5) screen 40' 88' (length) (depth to top)
 8" PVC (size) (material)
- (6) pump 20 1100 (HP) (yield gpm)
 E (type power)
- (7) electric log No (yes or no)

(organization running log)

(8) how well bottom plugged PVC cap

DEPT. OF NATURAL RESOURCES
 BUREAU OF LAND & WATER RESOURCES


AUG 31 1984

RECEIVED

DRILLERS REMARKS:

If well telescopes please sketch and show depths.

GROUND LEVEL

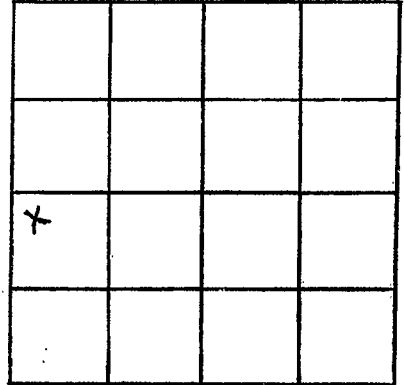

SECTION 18

Please indicate well location X.

ADDITIONAL INFORMATION

A series of horizontal lines for writing additional information.

If more than one screen, show locations of each on sketch.