

**MISSISSIPPI DEPARTMENT OF NATURAL RESOURCES**  
**Bureau of Land and Water Resources**  
 Southport Mall  
 P.O. Box 10631  
 Jackson, Mississippi 39209  
**WATER WELL DRILLERS LOG**

**CODED**

Washington
M 101

5-17 19 84 Larry's Well Pump Washington Co  
 date well completed firm name county well located

LANDOWNER: Gerald Frey  
Darlowe Miss  
 (mailing address)

description of formations encountered	from	to
<u>clay</u>	<u>0</u>	<u>20</u>
<u>Fine Sand</u>	<u>20</u>	<u>40</u>
<u>coarse Sand</u>	<u>40</u>	<u>100</u>

WELL LOCATION:  
 sec. 22 T 16 (N) S R 0 E (W)  
2 miles WEST of Darlowe  
 (distance) (direction) (nearest town)

WELL PURPOSE:  
 (home, irrigation, municipal, industrial)

- WELL COMPLETION DATA:
- (1) diameter (inches) 6"
  - (2) total depth (feet) 100
  - (3) static water level (feet) 20 below above top of ground.
  - (4) casing plastic, 60'  
(material) (depth)  
6" If telescope see back.  
(size)
  - (5) screen 40, 60  
(length) (depth to top)  
6", plastic  
(size) (material)
  - (6) pump 5, 200  
(HP) (yield gpm)  
E  
(type power)
  - (7) electric log no  
(yes or no)

**CODED**

DEPT. OF NATURAL RESOURCES  
 BUREAU OF LAND & WATER RESOURCES

SEP 10 1984


**RECEIVED**

(organization running log)  
 (8) how well bottom plugged cap

DRILLERS REMARKS:

If well telescopes please sketch and show depths.

GROUND LEVEL

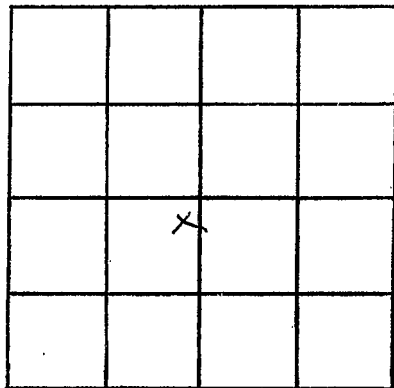

SECTION 23

Please indicate well location X.

ADDITIONAL INFORMATION

If more than one screen,  
show locations of each on sketch.