

**MISSISSIPPI DEPARTMENT OF NATURAL RESOURCES**  
**Bureau of Land and Water Resources**  
 Southport Mall  
 P.O. Box 10631  
 Jackson, Mississippi 39209  
**WATER WELL DRILLERS LOG**

**CODED**

<b>WASHINGTON</b>
CL-2681
M103

5/15 19 84 LAYNE-CENTRAL CO. WASHINGTON  
 date well completed firm name county well located

LANDOWNER:	description of formations encountered	from	to
Murphy Jones			
Nitta Yuma, MS (mailing address)	sand	21	40
	coarse sand	40	60
	coarse sand gravel	60	118
<b>WELL LOCATION:</b>			
sec. <u>20</u> T. <u>16</u> N. R. <u>5</u> <u>W</u>			
<u>3</u> miles <u>E</u> of <u>Darlove</u> (distance) (direction) (nearest town)			
<b>WELL PURPOSE:</b> <u>irrigation</u> (home, irrigation, municipal, industrial)			
<b>WELL COMPLETION DATA:</b>			
(1) diameter (inches) <u>20"</u>			
(2) total depth (feet) <u>118'</u>			
(3) static water level (feet) <u>21'</u> below top of ground.			
(4) casing <u>PVC</u> <u>78'</u> (material) (depth)			
<u>8"</u> (size) if telescope see back.			
(5) screen <u>40'</u> <u>78'</u> (length) (depth to top)			
<u>8"</u> <u>PVC</u> (size) (material)			
(6) pump <u>15</u> <u>900</u> (HP) (yield gpm)			
<u>electric</u> (type power)			
(7) electric log <u>no</u> (yes or no)			
<u>(organization running log)</u>			
(8) how well bottom plugged <u>PVC cap</u>			

**CODED**

DEPT. OF NATURAL RESOURCES  
 BUREAU OF LAND & WATER RESOURCES


SEP 21 1984

**RECEIVED**

DRILLERS REMARKS: \_\_\_\_\_

If well telescopes please sketch and show depths.

GROUND LEVEL

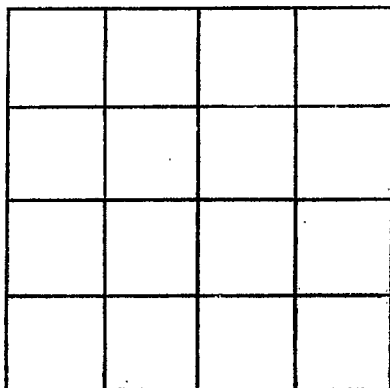

SECTION \_\_\_\_\_

Please indicate well location X.

ADDITIONAL INFORMATION

If more than one screen,  
show locations of each on sketch.