

MISSISSIPPI DEPARTMENT OF NATURAL RESOURCES
Bureau of Land and Water Resources
 Southport Mall
 P.O. Box 10631
 Jackson, Mississippi 39209
WATER WELL DRILLERS LOG

CODED

WASHINGTON
 M104

5-21 19 84 *Larry's Well & Pump Co* *Washington*
 date well completed firm name county well located

LANDOWNER: *Ted Greer*
Hollandale Miss

description of formations encountered	from	to
	<i>clay</i>	<i>0</i>
<i>Fine Sand</i>	<i>30</i>	<i>50</i>
<i>Coarse Sand</i>	<i>50</i>	<i>117'</i>

(mailing address)

WELL LOCATION:
 sec. *17* T. *16* N R. *6* E
 S W
7 miles *E.* of *Hollandale*
 (distance) (direction) (nearest town)

WELL PURPOSE:
 (home, irrigation, municipal, industrial)

WELL COMPLETION DATA:

- (1) diameter (inches) *16"*
- (2) total depth (feet) *117'*
- (3) static water level (feet) *20* below/above top of ground.
- (4) casing *plastic*, *77'*
 (material) (depth)
 16" if telescope see back.
 (size)
- (5) screen *40*, *77'*
 (length) (depth to top)
 16", *plastic*
 (size) (material)
- (6) pump *60*, *3000*
 (HP) (yield gpm)
 0
 (type power)
- (7) electric log *no*
 (yes or no)

(organization running log)

(8) how well bottom plugged *Steel Plate*

DRILLERS REMARKS:

CODED


DEPT. OF NATURAL RESOURCES
 BUREAU OF LAND & WATER RESOURCES

OCT - 2 1984

RECEIVED

If well telescopes please sketch and show depths.

GROUND LEVEL

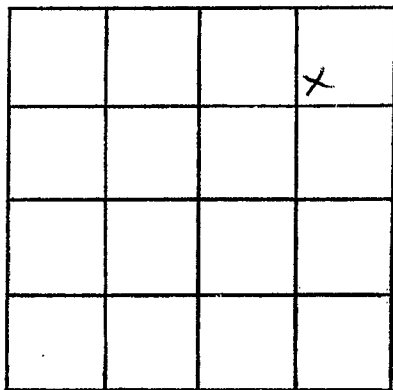

SECTION 17

Please indicate well location X.

ADDITIONAL INFORMATION

If more than one screen,
show locations of each on sketch.