

MISSISSIPPI DEPARTMENT OF NATURAL RESOURCES

Bureau of Land and Water Resources

Southport Mall

P.O. Box 10631

Jackson, Mississippi 39209

WATER WELL DRILLERS LOG

CODED

WASHINGTON  
M105

May 31  
date well completed

1984 Larry's Well & Pump  
firm name

Washington  
county well located

LANDOWNER: Marc Parrish  
  
Cock, Ms  
(mailing address)

description of formations encountered	from	to
	Clay	0
Fine Sand	30	50
Coarse Sand & gravel	50	100

WELL LOCATION:  
sec 35 T 16 N R 6 E  
S W  
4 miles East of Hallsdale  
(distance) (direction) (nearest town)

CODED

WELL PURPOSE:  
(home, irrigation, municipal, industrial)

WELL COMPLETION DATA:

- (1) diameter (inches) 8"
- (2) total depth (feet) 100'
- (3) static water level (feet) 24' below top of ground.
- (4) casing PVC, 60' (material) (depth)  
(size) If telescope see back.
- (5) screen 40' 60' (length) (depth to top)  
8" PVC (size) (material)
- (6) pump 20 (HP) 1100 (yield gpm)  
Electric (type power)
- (7) electric log No (yes or no)  
(organization running log)
- (8) how well bottom plugged PVC cap

DEPT. OF NATURAL RESOURCES  
BUREAU OF LAND & WATER RESOURCES


OCT - 2 1984

RECEIVED

DRILLERS REMARKS:

If well telescopes please sketch and show depths.

GROUND LEVEL

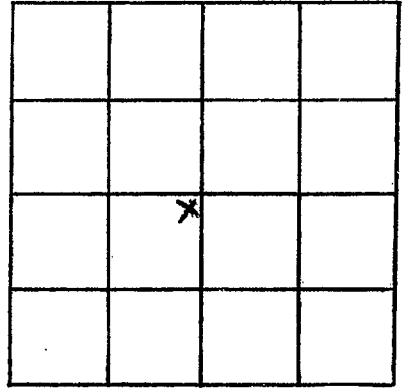

SECTION 35

Please indicate well location X.

ADDITIONAL INFORMATION

If more than one screen,  
show locations of each on sketch.