

WASHINGTON  
M106

MISSISSIPPI DEPARTMENT OF NATURAL RESOURCES  
Bureau of Land and Water Resources  
Southport Mall  
P.O. Box 10631  
Jackson, Mississippi 39209  
WATER WELL DRILLERS LOG

CODED

May 31 1984 date well completed  
Larry's Well Pump firm name  
Washington county well located

LANDOWNER: Marc Jannich  
Leola, Mo.  
(mailing address)

description of formations encountered	from	to
clay	0	30
fine sand	30	50
coarse sand & gravel	50	100

WELL LOCATION:  
sec 35 T 16 N R 6 E  
S 6 W  
4 miles East of Hollandale  
(distance) (direction) (nearest town)

WELL PURPOSE:  
(home, irrigation, municipal, industrial)

- WELL COMPLETION DATA:
- (1) diameter (inches) 8"
  - (2) total depth (feet) 100'
  - (3) static water level (feet) 24' below top of ground.
  - (4) casing PVC, 60' (material) (depth)
  - (size) if telescope see back.
  - (5) screen 40' 60' (length) (depth to top)
  - 8" PVC (size) (material)
  - (6) pump 20 1100 (HP) (yield gpm)
  - E (type power)
  - (7) electric log no (yes or no)
  - (organization running log)
  - (8) how well bottom plugged PVC cap

CODED

DEPT. OF NATURAL RESOURCES  
BUREAU OF LAND & WATER RESOURCES


OCT - 2 1984

RECEIVED

DRILLERS REMARKS:

If well telescopes please sketch and show depths.

GROUND LEVEL

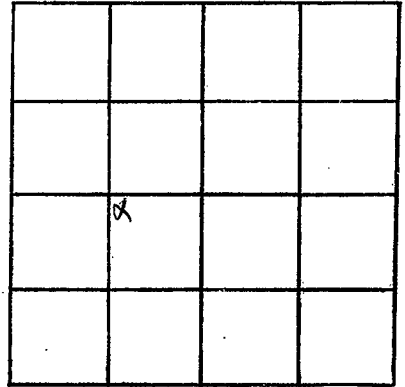

SECTION 35

Please indicate well location X.

ADDITIONAL INFORMATION

If more than one screen,  
show locations of each on sketch.