

MISSISSIPPI DEPARTMENT OF NATURAL RESOURCES

Bureau of Land and Water Resources

Southport Mall

P.O. Box 10631

Jackson, Mississippi 39209

WATER WELL DRILLERS LOG

CODED

WASHINGTON
M109
4-25-86

4-25-86
date well completed

19 IRRIGATION EQUIPMENT
firm name

WASHINGTON
county well located

LANDOWNER: Charles Fitts
Rt. 1, BOX 175
MOOREHEAD MS
(mailing address)

description of formations encountered

from

to

CLAY	0	65
FINE SAND	65	75
COARSE SAND / pea gravel	75	117

WELL LOCATION:

sec. 31 T. 16 N. R. 5 E
S W
6 miles EAST of Hollandale
(distance) (direction) (nearest town)

WELL PURPOSE: Fish ponds
(home, irrigation, municipal, industrial)

WELL COMPLETION DATA:


- (1) diameter (inches) 16"
- (2) total depth (feet) 117
- (3) static water level (feet) 30 ^{below} / _{above} top of ground.
- (4) casing STEEL 77'
(material) (depth)
16" if telescope see back.
(size)
- (5) screen 40' 77'
(length) (depth to top)
16" STEEL
(size) (material)
- (6) pump 60 2000
(HP) (yield gpm)
Electric
(type power)
- (7) electric log NO
(yes or no)

(organization running log)

(8) how well bottom plugged STEEL PLATE

DRILLERS REMARKS:

#86114KSE03

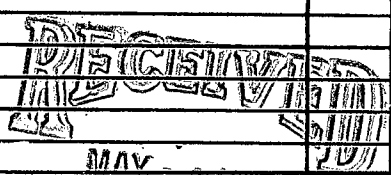


MAY 6 1986

Department of Natural Resources
Bureau of Land & Water Resources

If well telescopes please sketch and show depths.

IRRIGATION EQUIPMENT, INC.
P.O. BOX 708
INDIANOLA, MS 38751

GROUND LEVEL

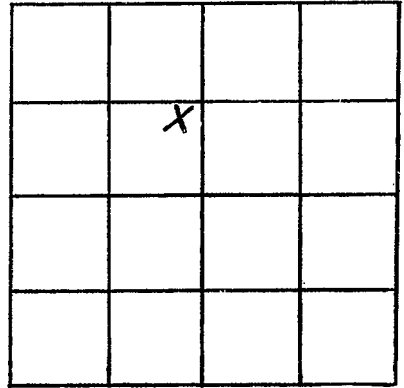

SECTION 31

Please indicate well location X.

ADDITIONAL INFORMATION

If more than one screen,
show locations of each on sketch.