

MISSISSIPPI DEPARTMENT OF NATURAL RESOURCES

Bureau of Land and Water Resources

Southport Mall

P.O. Box 10631

Jackson, Mississippi 39209

WATER WELL DRILLERS LOG

CODED

WASHINGTON
M110

4-24-86 19 IRRIGATION EQUIPMENT WASHINGTON
date well completed firm name county well located

LANDOWNER: Charles Fitts
Rt. 1, BOX 175
morehead, MS
(mailing address)

description of formations encountered	from	to
CLAY	0	25
FINE SAND	25	70
COARSE SAND / pea gravel	70	115


WELL LOCATION:
sec. 31 T 16 N R 5 E
S W
6 miles EAST of Hollandale
(distance) (direction) (nearest town)

WELL PURPOSE: Fish ponds
(home, irrigation, municipal, industrial)

WELL COMPLETION DATA:

- (1) diameter (inches) 16"
- (2) total depth (feet) 115
- (3) static water level (feet) 30 ^{below} above top of ground.
- (4) casing steel, 75' (material) (depth)
16" (size) if telescope see back.
- (5) screen 40' 75' (length) (depth to top)
16" (size) STEEL (material)
- (6) pump 60 3000 (HP) (yield gpm)
Electric (type power)
- (7) electric log NO (yes or no)
- (8) how well bottom plugged STEEL PLATE

DRILLERS REMARKS:
B6066 KSE01

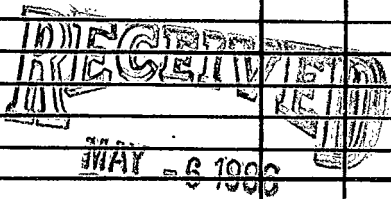


Department of Natural Resources
Bureau of Land and Water Resources

If well telescopes please sketch and show depths.

IRRIGATION EQUIPMENT, INC.
P.O. BOX 708
INDIANOLA, MS 38751

GROUND LEVEL

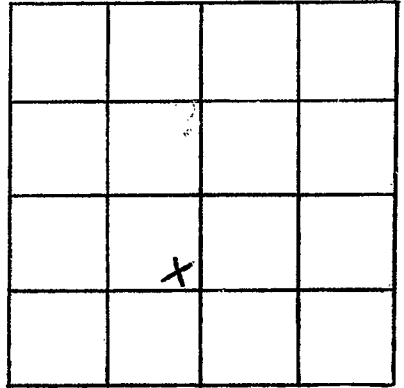

SECTION 31

Please indicate well location X.

ADDITIONAL INFORMATION

If more than one screen,
show locations of each on sketch.