

MISSISSIPPI DEPARTMENT OF NATURAL RESOURCES

Bureau of Land and Water Resources

Southport Mall

P.O. Box 10631

Jackson, Mississippi 39209

WATER WELL DRILLERS LOG

CODED

WASHINGTON  
M11  
3-19-85

March 19, 1985 date well completed  
Larry's Well & Pump firm name  
Washington county well located

LANDOWNER: Dan Skuriss

description of formations encountered

from

to

Clay

0

26

Fine sand

26

30

coarse sand

30

106

Hollandale, Mo.  
(mailing address)

WELL LOCATION:

sec. 27 T. 16 N. R. 6 E. S. 5  
(distance) miles (direction) of Hollandale (nearest town)


CODED

WELL PURPOSE:

(home, irrigation, municipal, industrial)

WELL COMPLETION DATA:

- (1) diameter (inches) 16"
- (2) total depth (feet) 106'
- (3) static water level (feet) 24' below top of ground.
- (4) casing steel, 66' (material) (depth)  
(size) if telescope see back.
- (5) screen 40' 66' (length) (depth to top)  
16" steel (size) (material)
- (6) pump 60 3000 (HP) (yield gpm)  
0 (type power)
- (7) electric log no. (yes or no)
- (organization running log)

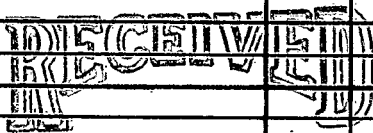

JUN 12 1985


Department of Natural Resources  
Bureau of Land & Water Resources

(8) how well bottom plugged Steel Plate

DRILLERS REMARKS:

If well telescopes please sketch and show depths.

GROUND LEVEL

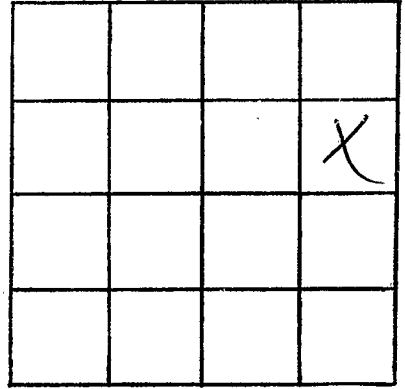

SECTION 27

Please indicate well location X.

ADDITIONAL INFORMATION

If more than one screen, show locations of each on sketch.