

MISSISSIPPI DEPARTMENT OF NATURAL RESOURCES

Bureau of Land and Water Resources

Southport Mall

P.O. Box 10631

Jackson, Mississippi 39209

WATER WELL DRILLERS LOG

WASHINGTON
M 113

CODED

6-21-86 19 IRRIGATION EQUIPMENT WASHINGTON  
 date well completed firm name county well located

LANDOWNER: <u>JAMES CREEK</u>	description of formations encountered	from	to
<u>RANCH INC. Rt. 2, Box 170</u>			
<u>HOLLANDALE, MS 38748</u> (mailing address)	<u>CLAY</u>	<u>0</u>	<u>25</u>
	<u>FINE SAND</u>	<u>25</u>	<u>80</u>
	<u>COARSE SAND / GRAVEL</u>	<u>80</u>	<u>120</u>

WELL LOCATION:  
 sec 28 T 16 S R 6 E  
1 1/2 miles NE of HOLLANDALE  
 (distance) (direction) (nearest town)

WELL PURPOSE: FISH PONDS  
 (home, irrigation, municipal, industrial)

WELL COMPLETION DATA:

(1) diameter (inches) 16"

(2) total depth (feet) 120

(3) static water level (feet) 28 below above top of ground.

(4) casing Steel 80'  
 (material) (depth)  
16" if telescope see back.  
 (size)

(5) screen 40 80'  
 (length) (depth to top)  
1 1/2" STEEL  
 (size) (material)


(6) pump 60 3000  
 (HP) (yield gpm)  
Diesel  
 (type power)

(7) electric log NO  
 (yes or no)

(organization running log)

(8) how well bottom plugged steel plate

CODED

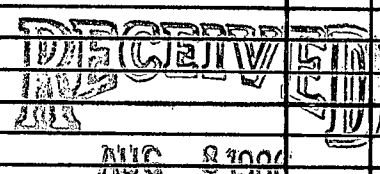


DRILLERS REMARKS:  
#86111MSG04  
MSGWO3042

Department of Natural Resources  
 Bureau of Land and Water Resources

If well telescopes please sketch and show depths.

2000

GROUND LEVEL

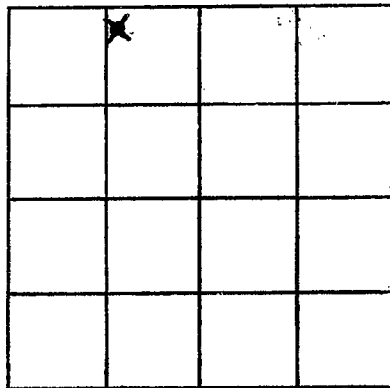

SECTION 28

Please indicate well location X.

ADDITIONAL INFORMATION

Lined area for additional information.

If more than one screen, show locations of each on sketch.