

MISSISSIPPI DEPARTMENT OF NATURAL RESOURCES

Bureau of Land and Water Resources

Southport Mall

P.O. Box 10631

Jackson, Mississippi 39209

WATER WELL DRILLERS LOG

WASHINGTON
M 114

CODED.

7-13-86
date well completed

IRRIGATION EQUIPMENT
firm name

WASHINGTON
county well located

LANDOWNER: JAMES CREEK
RANCH INC. Rt. 2, BOX 170
HOLLANDALE, MS 38748
(mailing address)

description of formations encountered

from

to

clay 0 15
FINE SAND / CLAY 15 50
COARSE SAND / GRAVEL 50 108

WELL LOCATION:


sec. 28 T. 16 (N) S R. 6 (W) E
1/2 miles NE of HOLLANDALE
(distance) (direction) (nearest town)

WELL PURPOSE: FISH PONDS
(home, irrigation, municipal, industrial)

WELL COMPLETION DATA:

- (1) diameter (inches) 16"
(2) total depth (feet) 108
(3) static water level (feet) 27 below above top of ground.
(4) casing steel 68
(material) (depth)
16" if telescope see back.
(size)
(5) screen 40' 68'
(length) (depth to top)
16" steel
(size) (material)
(6) pump 60 3000
(HP) (yield gpm)
Diesel
(type power)
(7) electric log NO
(yes or no)

CODED

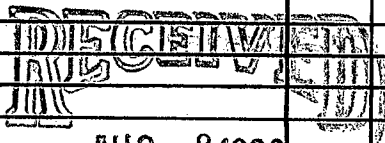

AUG 9 1986

Department of Natural Resources
Bureau of Land & Water Resources

(organization running log)

(8) how well bottom plugged steel plate

DRILLERS REMARKS:


#86111MSG03

MSGW03043

If well telescopes please sketch and show depths.

IRRIGATION EQUIPMENT
601/887-2535
INDIANOLA, MS

GROUND LEVEL

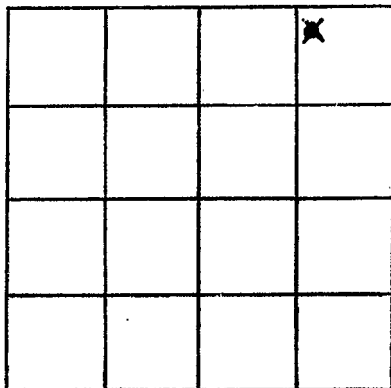

SECTION 28

Please indicate well location X.

ADDITIONAL INFORMATION

If more than one screen,
show locations of each on sketch.