

MISSISSIPPI DEPARTMENT OF NATURAL RESOURCES

Bureau of Land and Water Resources

Southport Mall

P.O. Box 10631

Jackson, Mississippi 39209

WATER WELL DRILLERS LOG

WASHINGTON
M 115

CODED

7-14-86
date well completed

IRRIGATION EQUIPMENT
firm name

WASHINGTON
county well located

LANDOWNER: GAMES CREEK
RANCH INC. RT. 2, BOX 170
HOLLANDALE, MS 38748
(mailing address)

description of formations encountered

from

to

clay	0	15
clay / FINE SAND	15	65
COARSE SAND / PEA GRAVEL	65	115

WELL LOCATION:


sec 28 T-16 (N) R-6 (E)
S (W)
1/2 miles NE of Hollandale
(distance) (direction) (nearest town)

WELL PURPOSE: FISH PONDS
(home, irrigation, municipal, industrial)

WELL COMPLETION DATA:

- (1) diameter (inches) 16"
- (2) total depth (feet) 115'
- (3) static water level (feet) 30' below top of ground. above
- (4) casing STEEL 75'
(material) (depth)
16"
(size) if telescope see back.
- (5) screen 40' 75'
(length) (depth to top)
16" steel
(size) (material)
- (6) pump 60 3000
(HP) (yield gpm)
Diesel
(type power)
- (7) electric log NO
(yes or no)

CODED

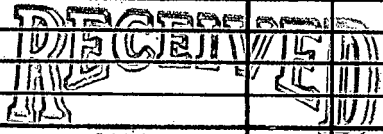

AUG 8 1986

(organization running log)

(8) how well bottom plugged steel plate

DRILLERS REMARKS:

#86111 MSG 05


MSGW03045

Department of Natural Resources
Bureau of Land & Water Resources

If well telescopes please sketch and show depths.

IRRIGATION EQUIPMENT
601/887-2555
INDIANOLA, MS

GROUND LEVEL

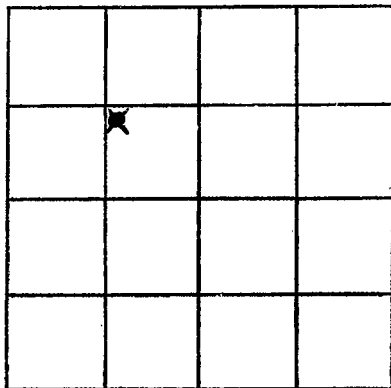

SECTION 28

Please indicate well location X.

ADDITIONAL INFORMATION

If more than one screen,
show locations of each on sketch.