

MISSISSIPPI DEPARTMENT OF NATURAL RESOURCES

Bureau of Land and Water Resources

Southport Mall

P.O. Box 10631

Jackson, Mississippi 39209

WATER WELL DRILLERS LOG

WASHINGTON
M 116

CODED.

6-20-86
date well completed

IRRIGATION EQUIPMENT
firm name

WASHINGTON
county well located

LANDOWNER: JAMES CREEK RANCH
INC. Rt. 2, BOX 170
HOLLANDALE, MS 38748
(mailing address)

description of formations
encountered

from

to

CLAY 0 35
FINE SAND 35 55
COARSE SAND / GRAVEL 55 108

WELL LOCATION:


sec 21 T 16 N R 6 E
S
1 1/2 miles NE of Hollandale
(distance) (direction) (nearest town)

WELL PURPOSE: FISH PONDS
(home, irrigation, municipal, industrial)

WELL COMPLETION DATA:

- (1) diameter (inches) 16"
- (2) total depth (feet) 108
- (3) static water level (feet) 30 below top of ground.
- (4) casing STEEL 68'
(material) (depth)
16" (size) if telescope see back.
- (5) screen 40' 68'
(length) (depth to top)
16" STEEL
(size) (material)
- (6) pump 60 3000
(HP) (yield gpm)
Diesel
(type power)
- (7) electric log NO
(yes or no)

CODED

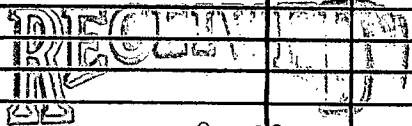

AUG 8 1986

(organization running log)

Steel plate

(8) how well bottom plugged

Department of Natural Resources
Bureau of Land and Water Resources

DRILLERS REMARKS:


#86111MGS01

MSGW03040

If well telescopes please
sketch and show depths.

IRRIGATION EQUIPMENT
601/887-2555
INDIANOLA, MS

GROUND LEVEL

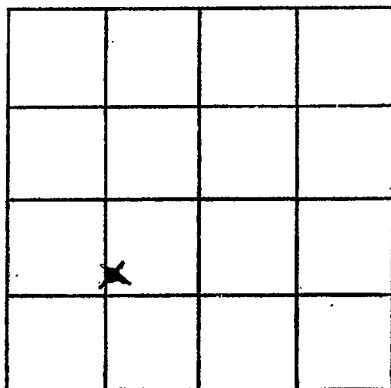

SECTION 21

Please indicate well location X.

ADDITIONAL INFORMATION

If more than one screen,
show locations of each on sketch.