

MISSISSIPPI DEPARTMENT OF NATURAL RESOURCES

Bureau of Land and Water Resources

Southport Mall

P.O. Box 10631

Jackson, Mississippi 39209

WATER WELL DRILLERS LOG

CODED

WASHINGTON
M 117

8-13-86 <sup>19</sup> Irrigation Equipment WASHINGTON  
 date well completed firm name county well located

LANDOWNER: James Creek  
RANCH INC. Rt. 2, Box 170  
Hollandale, ms 38748  
 (mailing address)

description of formations encountered	from	to
CLAY	0	30
FINE SAND	30	45
COARSE SAND / PEA GRAVEL	45	108

WELL LOCATION:  
 sec 28 T 16 (N) R 6 (E)  
1 1/2 miles NE of Hollandale  
 (distance) (direction) (nearest town)

CODED

WELL PURPOSE: FISH POND  
 (home, irrigation, municipal, industrial)

WELL COMPLETION DATA:

(1) diameter (inches) 16"

(2) total depth (feet) 108

(3) static water level (feet) 30 <sup>below</sup> above top of ground.

(4) casing steel 68"  
 (material) (depth)  
16" if telescope see back.  
 (size)

(5) screen 40' 68"  
 (length) (depth to top)  
16" steel  
 (size) (material)

(6) pump 60 3000  
 (HP) (yield gpm)  
Diesel  
 (type power)

(7) electric log NO  
 (yes or no)  
 (organization running log) steel plate

(8) how well bottom plugged plate

RECEIVED  
 AUG 25 1986


Department of Natural Resources  
 Bureau of Land & Water Resources

DRILLERS REMARKS:  
# 86111 MSG 06  
MSG W03044

If well telescopes please sketch and show depths.

IRRIGATION EQUIPMENT  
601/887-2555  
INDIANOLA, MS

GROUND LEVEL

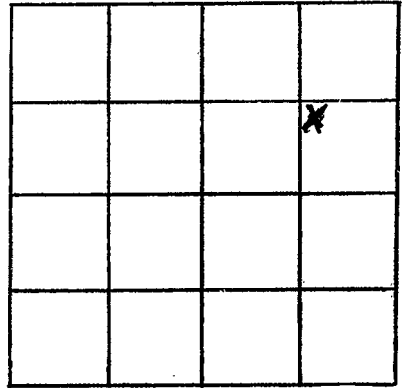

SECTION 28

Please indicate well location X.

ADDITIONAL INFORMATION

If more than one screen,  
show locations of each on sketch.