

MISSISSIPPI DEPARTMENT OF NATURAL RESOURCES

Bureau of Land and Water Resources

Southport Mall

P.O. Box 10631

Jackson, Mississippi 39209

WATER WELL DRILLERS LOG

CODED

WASHINGTON
M118
GW 4020

July 28 1986 date well completed
Larry's Well Pump firm name
Washington county well located

LANDOWNER: Joe Jimbatrie
Hollandale, Mo.
(mailing address)

| description of formations encountered | from | to |
|---------------------------------------|------|-----|
| clay | 0 | 30 |
| Finest Sand | 30 | 80 |
| course Sand & gravel | 80 | 126 |

WELL LOCATION:
33 sec 32 T 16 N R E
S S W
7 miles E of Hollandale
(distance) (direction) (nearest town)

CODED

WELL PURPOSE: Fish Pond
(home, irrigation, municipal, industrial)

- WELL COMPLETION DATA:
- (1) diameter (inches) 12"
 - (2) total depth (feet) 126'
 - (3) static water level (feet) 26' below top of ground.
 - (4) casing Steel, 86' (material) (depth)
If telescope see back. (size)
 - (5) screen 40', 86' (length) (depth to top)
12" Steel (size) (material)
 - (6) pump 40 (HP) 2000 (yield gpm)
Elec (type power)
 - (7) electric log (yes or no) No
(organization running log)
 - (8) how well bottom plugged Steel Plate


REGISTERED
TRIGLUMEN
SEP 26 1986

Department of Natural Resources
Bureau of Land and Water Resources

DRILLERS REMARKS:

If well telescopes please sketch and show depths.

GROUND LEVEL

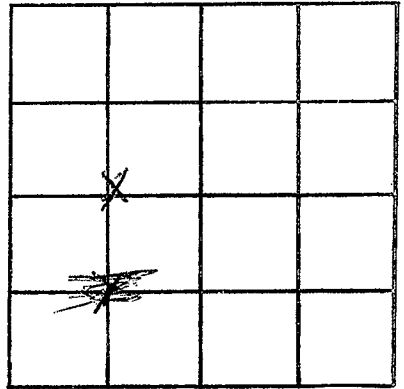

SECTION 52

Please indicate well location X.

ADDITIONAL INFORMATION

If more than one screen,
show locations of each on sketch.