

MISSISSIPPI DEPARTMENT OF NATURAL RESOURCES

Bureau of Land and Water Resources

Southport Mall

P.O. Box 10631

Jackson, Mississippi 39209

WATER WELL DRILLERS LOG

CODED

WASHINGTON
M 119
GW 4021

July 28
date well completed

1986 Lamp's Well & Pump
firm name

Washington
county well located

LANDOWNER: Joe Trombatore

description of formations encountered

from to

Hollandale, MS.
(mailing address)

clay 0 30
Fine Sand 30 50
course Sand & gravel 50 103

WELL LOCATION:

38 sec 32 T 16 N R E
S S W
7 miles E of Hollandale
(distance) (direction) (nearest town)

CODED

WELL PURPOSE: Fish Pond
(home, irrigation, municipal, industrial)

WELL COMPLETION DATA:

- (1) diameter (inches) 16"
- (2) total depth (feet) 103'
- (3) static water level (feet) 26' ^{below}/_{above} top of ground.
- (4) casing Steel, 63'
(material) (depth)

If telescope see back.
(size)

- (5) screen 40' 63'
(length) (depth to top)

16" Steel
(size) (material)

- (6) pump 60 HP 3000
(HP) (yield gpm)


Elec.
(type power)

- (7) electric log No.
(yes or no)

(organization running log)

- (8) how well bottom plugged Steel plate

DRILLERS REMARKS:

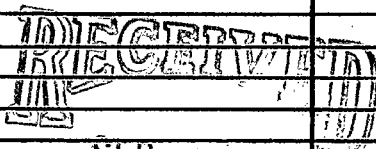


SEP 26 1986

Department of Natural Resources
Bureau of Land and Water

If well telescopes please sketch and show depths.

GROUND LEVEL

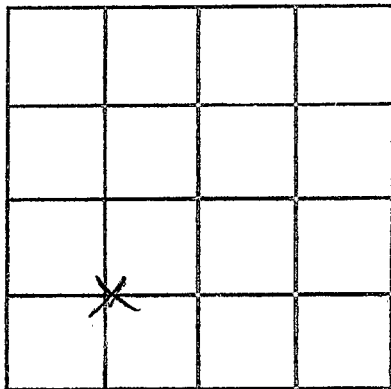

SECTION 32

Please indicate well location X.

ADDITIONAL INFORMATION

If more than one screen,
show locations of each on sketch.