

MISSISSIPPI DEPARTMENT OF NATURAL RESOURCES

Bureau of Land and Water Resources

Southport Mall

P.O. Box 10631

Jackson, Mississippi 39209

WATER WELL DRILLERS LOG

CODED

WASHINGTON  
MIZO

March 26 1986 date well completed  
Larry's Well Pump firm name  
Washington county well located

LANDOWNER: David Miller  
K & M Fish  
Hollandale Mo.  
(mailing address)

description of formations encountered	from	to
<u>clay</u>	<u>0</u>	<u>30</u>
<u>fine sand</u>	<u>30</u>	<u>50</u>
<u>course sand</u>	<u>50</u>	<u>105</u>

WELL LOCATION:  
sec. 27 T 16 N R 6 E  
S W  
1 N 2 miles 2 E of Hollandale  
(distance) (direction) (nearest town)

CODED

WELL PURPOSE: Fish Pond  
(home, irrigation, municipal, industrial)

WELL COMPLETION DATA:

(1) diameter (inches) 12"

(2) total depth (feet) 105'

(3) static water level (feet) 23 <sup>below</sup>/<sub>above</sub> top of ground.

(4) casing steel 65'  
(material) (depth)  
12" if telescope see back.  
(size)

(5) screen 40' 65'  
(length) (depth to top)  
12" Steel  
(size) (material)

(6) pump 40 2000  
(HP) (yield gpm)  
D  
(type power)

(7) electric log NO  
(yes or no)  
          
(organization running log)

(8) how well bottom plugged Steel  
plate


RECEIVED  
BUREAU OF LAND AND WATER RESOURCES  
SEP 25 1986

Department of Natural Resources  
Bureau of Land and Water Resources

DRILLERS REMARKS:

If well telescopes please sketch and show depths.

GROUND LEVEL

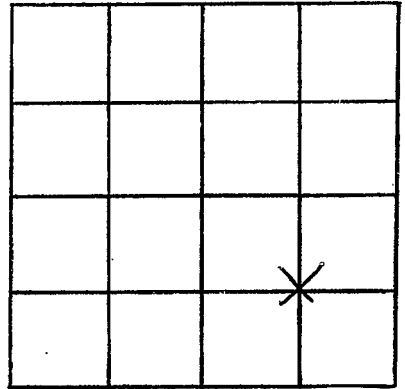

SECTION 27

Please indicate well location X.

ADDITIONAL INFORMATION

If more than one screen,  
show locations of each on sketch.