

MISSISSIPPI DEPARTMENT OF NATURAL RESOURCES

Bureau of Land and Water Resources

Southport Mall

P.O. Box 10631

Jackson, Mississippi 39209

WATER WELL DRILLERS LOG

Washington
M124

6-9-87 date well completed
1987 Schwitz Drilling firm name
Washington county well located


LANDOWNER: Cross Plantation
Arcola, MS
(mailing address)

description of formations encountered	from	to
CLAY	0	22
SAND	22	75
SAND + GRAVEL	75	116

WELL LOCATION:
sec. 7 T 16 N R 5 E
4 miles E of Arcola
(distance) (direction) (nearest town)

WELL PURPOSE: IRRIGATION
(home, irrigation, municipal, industrial)

- WELL COMPLETION DATA:
- (1) diameter (inches) 16"
 - (2) total depth (feet) 115'
 - (3) static water level (feet) 28' below/above top of ground.
 - (4) casing STEEL, 75'
(material) (depth)
 - (size) If telescope see back.
 - (5) screen 40', 75'
(length) (depth to top)
 - 16", Steel
(size) (material)
 - (6) pump 60, 3000
(HP) (yield gpm)
 - gear-drive
(type power)
 - (7) electric log NO.
(yes or no)
 - X
(organization running log)
 - (8) how well bottom plugged cap

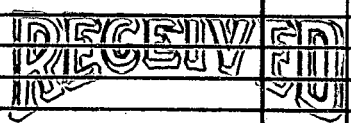


JUL 3 1987

Department of Natural Resources
Bureau of Land & Water Resources

DRILLERS REMARKS:

If well telescopes please sketch and show depths.

GROUND LEVEL

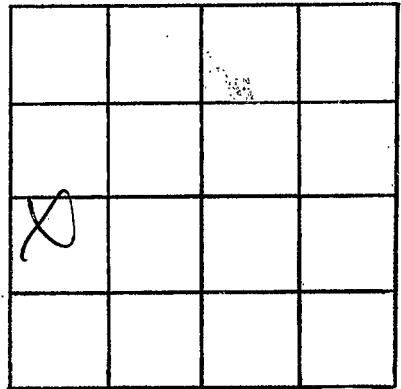

SECTION 2

Please indicate well location X.

ADDITIONAL INFORMATION

If more than one screen,
show locations of each on sketch.