

MISSISSIPPI DEPARTMENT OF NATURAL RESOURCES

Bureau of Land and Water Resources

Southport Mall

P.O. Box 10631

Jackson, Mississippi 39209

WATER WELL DRILLERS LOG

WASHINGTON  
M 126  
7855

CODED

7-30-87, 19 Schultz Drilling, Inc. county well located

LANDOWNER: J.W. Potter  
P.O. Box 17  
Bonville, Mo. 38776  
(mailing address)

description of formations encountered	from	to
CLAY	0	15
SAND	15	40
SAND + PERGRAVEL	40	70
SAND + GRAVEL	70	110

WELL LOCATION:  
sec. 6-T-16-N R. 5-E  
3 miles E of TRALAKE  
(distance) (direction) (nearest town)

WELL PURPOSE: irrigation  
(home, irrigation, municipal, industrial)

WELL COMPLETION DATA:

(1) diameter (inches) 16"

(2) total depth (feet) 110'

(3) static water level (feet) 29' below above top of ground.

(4) casing PVC, 70'  
(material), (depth)

40 if telescope see back.  
(size)

(5) screen 40, 70'  
(length), (depth to top)

16", PVC  
(size), (material)

(6) pump 60, 3000  
(HP), (yield gpm)

PTO  
(type power)

(7) electric log NO  
(yes or no)

X  
(organization running log)

(8) how well bottom plugged CAP

DECEMBER 15 1987


OCT 05 1987

Department of Natural Resources  
Bureau of Land & Water Resources

DRILLERS REMARKS:

If well telescopes please sketch and show depths.

GROUND LEVEL

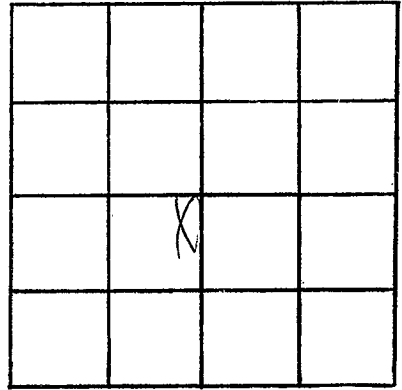

SECTION 6

Please indicate well location X.

ADDITIONAL INFORMATION

If more than one screen,  
show locations of each on sketch.