

MISSISSIPPI DEPARTMENT OF NATURAL RESOURCES

Bureau of Land and Water Resources

Southport Mall

P.O. Box 10631

Jackson, Mississippi 39209

WATER WELL DRILLERS LOG

MS-GW-  
04823  
WASHINGTON  
M 136

*Colo*

3-22 1988  
date well completed

Dyer Well  
firm name

Washington  
county well located

LANDOWNER: R. H. Ingram

Hwy 601 N Deer Creek  
 Island, Ms  
(mailing address)

description of formations encountered

from to

<u>Clay</u>	<u>0</u>	<u>28</u>
<u>Fine Sand</u>	<u>28</u>	<u>45</u>
<u>M Sand &amp; Gravel</u>	<u>45</u>	<u>55</u>
<u>Fine Sand</u>	<u>55</u>	<u>60</u>
<u>M Sand &amp; Gravel</u>	<u>60</u>	<u>70</u>
<u>Sands Gravel</u>	<u>70</u>	<u>118</u>

WELL LOCATION:

<sup>146 D</sup> sec 6 T 16 N R 6 E  
3 miles E of Acicola  
(distance) (direction) (nearest town)

WELL PURPOSE: irrigation  
(home, irrigation, municipal, industrial)

WELL COMPLETION DATA:

- (1) diameter (inches) 16"
- (2) total depth (feet) 118'
- (3) static water level (feet) \_\_\_\_\_ below  
top of ground. above
- (4) casing steel \_\_\_\_\_ (depth)  
(material) (depth)  
16 if telescope see back.  
(size)
- (5) screen 40 \_\_\_\_\_ (depth to top)  
(length) (depth to top)  
16 \_\_\_\_\_ (material)  
(size)
- (6) pump 60 \_\_\_\_\_ (yield gpm)  
(HP) (yield gpm)  
gear  
(type power)
- (7) electric log No \_\_\_\_\_ (yes or no)  
None  
(organization running log)
- (8) how well bottom plugged Plate

RECEIVED


MAY 02 1988

Department of Natural Resources  
Bureau of Land & Water Resources

DRILLERS REMARKS:

If well telescopes please sketch and show depths.

GROUND LEVEL

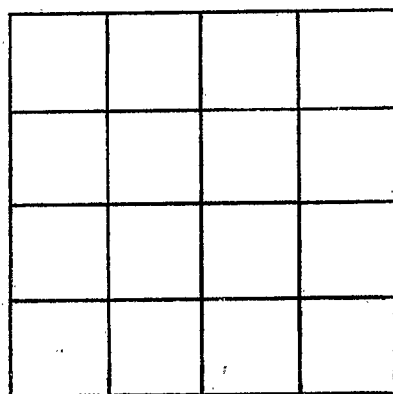

SECTION \_\_\_\_\_

Please indicate well location X.

ADDITIONAL INFORMATION

If more than one screen,  
show locations of each on sketch.