

MISSISSIPPI DEPARTMENT OF NATURAL RESOURCES

Bureau of Land and Water Resources

Southport Mall

P.O. Box 10631

Jackson, Mississippi 39209

WATER WELL DRILLERS LOG *Washington*

(WASHINGTON)
M 139

CODED

5-7-1988
 date well completed

Scholtz Drilling
 firm name

~~Seaflores~~
 county well located

LANDOWNER:	description of formations encountered	from	to
MARK POTTER Pt. 1. Box 951 Leland MS, (mailing address)	CLAY Medium SAND COARSE SAND SAND + peagravel	0 13 60 100	13 60 100 109
WELL LOCATION: sec. <u>6</u> T. <u>16</u> N R. <u>5</u> E <u>3</u> miles <u>E</u> of <u>Trotter</u> (distance) (direction) (nearest town)			
WELL PURPOSE: <u>IRRIGATION</u> (home, irrigation, municipal, industrial)			
WELL COMPLETION DATA:			
(1) diameter (inches) <u>16"</u>			
(2) total depth (feet) <u>109'</u>			
(3) static water level (feet) <u>31'</u> -below top of ground. above			
(4) casing <u>PVC</u> <u>69'</u> (material) (depth)			
<u>40'</u> If telescope see back. (size)			
(5) screen <u>16"</u> (length) <u>69'</u> (depth to top) <u>PVC</u> (size) (material)			
(6) pump <u>50</u> <u>2500</u> (HP) (yield gpm)			
<u>gear</u> (type power)			
(7) electric log <u>NO</u> (yes or no)			
<u>X</u> (organization running log)			
(8) how well bottom plugged <u>cap</u>			
DRILLERS REMARKS:			


RECEIVED

JUN 16 1988

Department of Natural Resources
 Bureau of Land & Water Resources

If well telescopes please sketch and show depths.

GROUND LEVEL

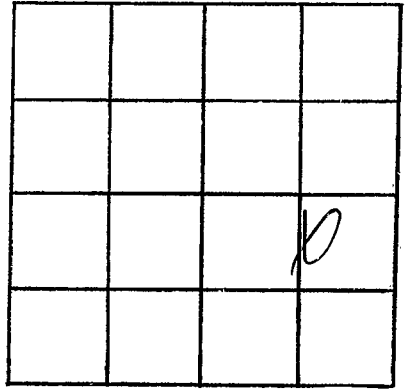

SECTION 6

Please indicate well location X.

ADDITIONAL INFORMATION

If more than one screen,
show locations of each on sketch.