

MISSISSIPPI DEPARTMENT OF NATURAL RESOURCES

Bureau of Land and Water Resources

Southport Mall

P.O. Box 10631

Jackson, Mississippi 39209

WATER WELL DRILLERS LOG

Permit Applied For  
 M 140  
 CODED

5-19-88 date well completed  
 Dyer Well firm name  
 Washington county well located

LANDOWNER: Hubert Farmer Services


description of formations encountered	from	to
Clay	0	24
F Sand + Gravel	24	34
M Sand + Gravel	34	105

G'ville Ms (mailing address)

WELL LOCATION:  
 sec. 23 T. 16 N. R. 6 E. S. 10 miles S of Amola (nearest town)

WELL PURPOSE: Sanitation (home, irrigation, municipal, industrial)

- WELL COMPLETION DATA:
- (1) diameter (inches) 16"
  - (2) total depth (feet) 105'
  - (3) static water level (feet) \_\_\_\_\_ below/above top of ground.
  - (4) casing PVC (material), \_\_\_\_\_ (depth), 16 (size) if telescope see back.
  - (5) screen 40 (length), \_\_\_\_\_ (depth to top), 16 (size), \_\_\_\_\_ (material)
  - (6) pump 60 (HP), \_\_\_\_\_ (yield gpm), Gear (type power)
  - (7) electric log No (yes or no), None (organization running log)
  - (8) how well bottom plugged Plate

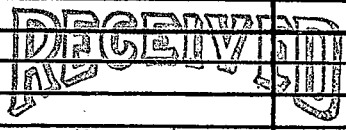


MAR 11 1988

Department of Natural Resources  
 Bureau of Land & Water Resources

DRILLERS REMARKS:

If well telescopes please sketch and show depths.

GROUND LEVEL

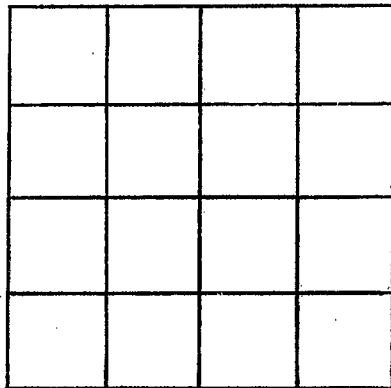

SECTION \_\_\_\_\_

Please indicate well location X.

ADDITIONAL INFORMATION

If more than one screen,  
show locations of each on sketch.