

MISSISSIPPI DEPARTMENT OF NATURAL RESOURCES

Bureau of Land and Water Resources

Southport Mall

P.O. Box 10631

Jackson, Mississippi 39209

WATER WELL DRILLERS LOG

Permit
Applied For
M 141
CODED

CODED

5-28 1988 Dyer Well Washington
date well completed firm name county well located

LANDOWNER: Huber Farm Services

Gville, Ms (mailing address)

WELL LOCATION:
sec. 26 T 16 N R 6 E
10 miles S of Arcola
(distance) (direction) (nearest town)

WELL PURPOSE: Irrigation
(home, irrigation, municipal, industrial)

- WELL COMPLETION DATA:
- (1) diameter (inches) 16"
 - (2) total depth (feet) 105'
 - (3) static water level (feet) _____ below above top of ground.
 - (4) casing PVC (material), (depth), 16" (size) If telescope see back.
 - (5) screen 40 (length), (depth to top) 16" (size), (material)
 - (6) pump 60 (HP), (yield gpm) Gear (type power)
 - (7) electric log No (yes or no) None (organization running log)
 - (8) how well bottom plugged Plate

description of formations encountered	from to	
Clay	0	24
Fine Sand	24	38
Sand & Gravel	38	58
M Sand & Gravel	58	65
Sand & Gravel	65	105

RECEIVED


JUL 11 1988

Department of Natural Resources
Bureau of Land & Water Resources

DRILLERS REMARKS:

If well telescopes please sketch and show depths.

GROUND LEVEL

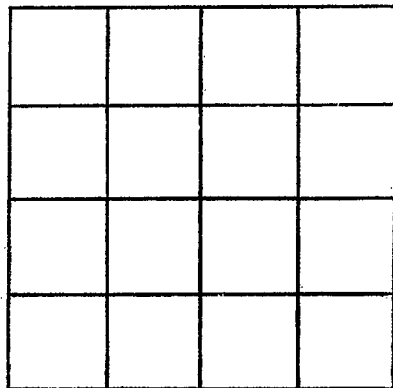

SECTION _____

Please indicate well location X.

ADDITIONAL INFORMATION

If more than one screen,
show locations of each on sketch.