
	crow - F			
1		ell Report	For Office Use Only:	
County: Washington	Part 1 Mississippi Department of Environmental Quality		Aquifer: M221	
Permit #: <u>GW-44726 /</u>	Office of Land an	d Water Resources	Well #:	
Driller: J. NewCome 0773	P.O. Box 10631 Jackson, MS 39289-0631		L. S. Elevation:	
Date drilling completed: 5-20-2011	(601)9	61-5210 -6938 (fax)	E-log #:	
State Law requires that this rep				
30 days of completion of drilling	g of the well.	· · ·		
Well Owner Information		Well Location		
Dwner Name Mary Crowe		Latitude: 33 . 11 . 02" Longitude: 090 49. 45.		
Mailing Address: P.S. Box 66		Method of Lat/Long (circle one): Conventional Survey,		
		USGS quad Hand-held GPS Survey-grade GPS		
Hollandale MS 38748		SW 4 SW 4 Sec 33 Twn 16N Rng 06W		
City State Zip Code		Distance Direction Nearest Town Lale Miles EAST of Hollen Lale		
Telephone No. ()		Miles EAST	of Hollen cale	
	Well I	Data		
Purpose of Well (circle one) Home In	idustrial Public Supply	Irrigation Fish Culture	Other:	
Date well drilling started: $5 - 24$				
If flowing, method of flow regulation: V	·			
Static Water Level:feet :				
Method of Measurement (circle one) Hole depth: Well of	steel tape electric tape		F 10 feet	
	_		- <u></u>	
Type of grout (circle one): Cement	Bentonite Mix		Prc	
· · · ·	asing diameter:	inches Type of casing		
Screen length: <u>40</u> feet So	creen diameter:	inches Type of screen:	486	
Screen slot size:	s Setting depth: From	70 feet to	D feet	
Type of completion (circle all applicable	e) Gravel packed Unde	rreamed Telescoped Op	en hole Natural Development	
	Other (describe):			
Top of lap pipe or reduction in casing: _	feet. If	telescoped or more than one	screen, describe on back of page	
Logs run (circle all applicable): No log				
Name of organization running log(s):	· · · · · · · · · · · · · · · · · · ·		· · ·	
I certify that the well was drilled, con	structed, and completed in			
Department of Environmental Qualit	y and/or the Mississippi D	epartment of Health regulati	ons and state laws.	
		•		
		Signatur	e of Water Well Contractor	
Print Name of Water Well Contractor a	and License No.	-		
Print Name of Water Well Contractor a	and License No.			
Print Name of Water Well Contractor a	and License No.			
Print Name of Water Well Contractor a	and License No.			

If well telescopes please sketch below and show depths.



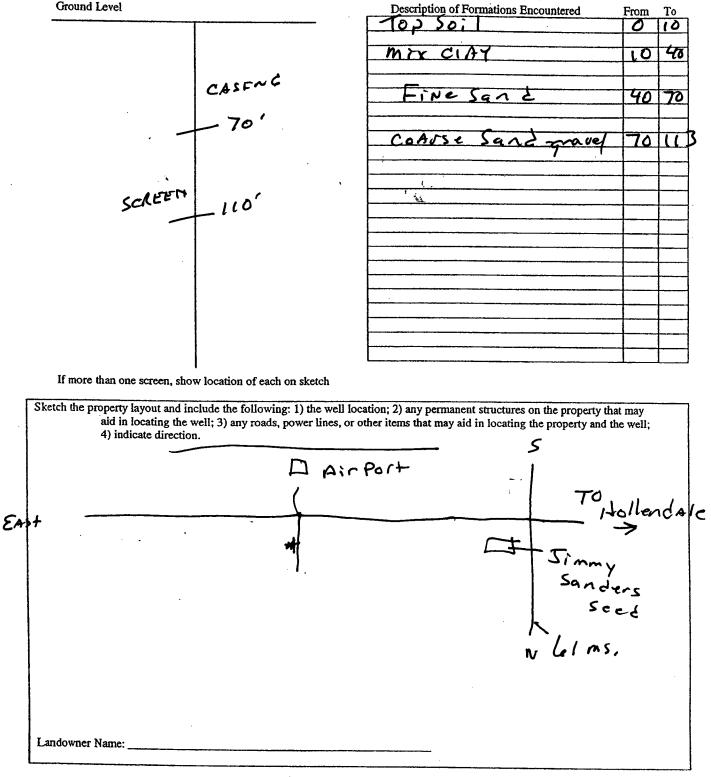

Signature of Water Well Contractor

West

County: Washington Permit #: GW - 44726 Driller: J. Newcome 0 773 Date completed: 5.20.2011 Copy information from block on Part 1	STATE WEI Pan Pump Installer's C Aississippi Department C Office of Land and P.O. Bo Jackson, N (601)96 (601)961-	rt 2 Completion Report of Environmental Qua d Water Resources ix 2309 MS 39225 i1-5210	Aquifer: Ality Well #:	r Office Use Only: M221
This part of the report must be completed by a report must be attached and both parts filed w Well Owner Information Owner Name: <u>Mary Crowe</u> Mailing Address: <u>P. O. Box 66</u> <u>Hollandale MG</u> City State	vith the Department at t 38748 Zip Code	he above address wit Latitude: 33    ·   Method of Lat/Long ( USGS quad, Ha GW 1/4 GW	hin 30 days of well Well Location 02.1. Longitude (check one): Conver and-held GPS <u>J</u> , S 1/4 Sec <u>7</u> <u>7</u> T	COMPLETION. C90: 49: 45: ntional Survey Survey-grade GPS IBN R OGW
Bucket Piston Tu Centrifugal Rotary Fl Other (specify): Date Pump Installed:	ubmersible urbine lowing Well	Distance Dir Miles E9	Power Type Circle one Gasoline Engine Hand Other (specify): of Motor:O	Natural G <b>as</b> Tractor PTO feet
Pump Test Data         Date Well Tested:	low Land Surface ow Land Surface low Land Surface llons Per Minute	Air Line Elec Other (specify): For flowing well, me Well yieldedfee	asured shut in head: GPM wi et after	Steel Tape
This is for (circle one): New Well I HEREBY CERTIFY that the above statement Comp Rowe Revealed to the statement Print Name of Purip Installer and License No.	ts are true to the best of $\frac{1}{2}$	ng Pump Rep	pair of Existing Pur	p

5 . . .

Signature of Pump Installer Form: OLWR-SWR-1C (07-09)