
FERRY	BUGH BURGOD
-------	-------------

FEREX BUGHBURGER
County: WASHINGTON Permit #: CMD-44919 Driller: J. NEWCOME 0:773 Driller: J. NEWCOME 0:773 Date drilling completed: II: W: 2011 State Law requires that this report be prepared by the license holder responsible for the work and filed with the Department at the above address within 30 days of completion of drilling of the well or borehole. Information on Well Owner Well or Borehole Location Latinude: 33 • 13 · All · Lonopitude 90 • 49 · O ·
Owner Name CC+B Farms Mailing Address: 28'7 W: Icutt Road Hollandale MS 38748 City State Zip Code Telephone No. Direction Nerest Town
Well / Borehole Data
Location of the source of any surface water used for drilling: FISH FOND Method of dosing and volume of Chlorine used in drilling and development: CHURE TREES Logs run (circle all applicable). No log run Electric Gamma Ray Density Sonic Neutron Other: Name of organization running log(s): Purpose of borehole (check one): Water Well Geotechnical/Geological Investigation Ground Source Heat Pump Seismic Survey Other (describe) If drilling is not related to water well construction, skip the remainder of this block
Purpose of Well (check one): HomeIndustrial Public SupplyIrrigation X Fish CultureOther: If a flowing well, method of flow regulation: ValveOther (describe) If a flowing well, method of flow regulation: ValveOther (describe) Other (describe) Static Water Level:feet above or below (circle one) land surface Date measured: Method of Measurement (circle one) steel tape electric tape air line other: Well depth: 120 Well grouted to a depth of 10 feet Type of grout (circle one): Neat Cemern Bentonite Mix Casing length:Ofeet Casing diameter:
Type of completion (circle all applicable): Underreamed Telescoped Open hole Natural Development Other (describe):
Form: OLWR-SWR-1A (04/08
RECI
FEB 1

BY: OLWR

1

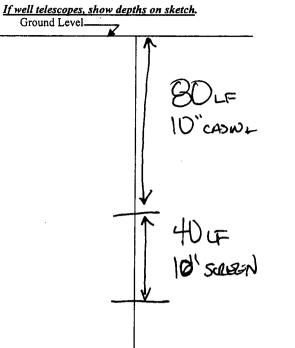

Description of formations encountered must be provided for	all
wells and boreholes, unless specifically exempted by regulati	

Description of Formations Encountered	From (depth)	To (depth)
TOP, SOIL	Ground Level	10
CLAY SAND	10	25
FINE MED SAND	25	40
MOD COARSE GAND	40	5
COAKSE SAND AUBOLES	65	120
BOITON	125	122
	1	

If more than one screen, show location of each on sketch

Sketch the property layout and include the following: 1) the well location; 2) any permanent structures on the property that may aid in locating the well; 3) any roads, power lines, or other items that may aid in locating the property and the well; 4) a north arrow. SEE MAP Landowner Name: Form: OLWR-SWR-1A (04/08)

I certify that the well/borehole was drilled, constructed, and completed in accordance with all applicable requirements of the Mississippi Department of Environmental Quality and the Mississippi Department of Health regulations, if applicable, and state

laws. NEWCOME 0.773 11.10.2011 JOHN

5

Print Name of Responsible Licensee and License No.

Date

Signature of Licensee

County: WASHINGTON Permit #: GW - 44919 Driller: J.NEWCOME O.T73 Date completed: 11-10 · 2011 Driller: 11-10 · 2011	ELL REPORT Part 2 's Completion Report nt of Environmental Quality and Water Resources Box 2309 n, MS 39225)961-5210 51-5228 (fax)
This part of the report must be completed by a licensed water well report must be attached and both parts filed with the Department well Owner Information Owner Name: C.C. & B. FARMS Mailing Address: 2.87 WILCUTT Ro. Houranter, Ms 38748 City State Telephone No. ()	contractor or a licensed pump installer. A copy of Part 1 of the at the above address within 30 days of well completion. Well Location Latitude: <u>33° 13' Of</u> Longitude: <u>OD · 49' 50°</u> Method of Lat/Long (check one): Conventional Survey55 USGS quad, Hand-held GPS X, Survey-grade GPS <u>NE</u> ¼ <u>SE</u> ¼ Sec <u>20</u> <u>T 16N</u> <u>R OLOW</u> Distance <u>Direction</u> Nearest Town <u>3.5</u> Miles <u>N.E.</u> of <u>HOLLANDALE</u>
Pump Type Circle one Jet Air Lift Jet Submersible Bucket Piston Turbine Centrifugal Rotary Flowing Well Other (specify): 30 TP 1 state Date Pump Installed: 11 - 114 - 2011 Rated Pump Capacity: 1000 Gallons Per Minute	Power Type Circle one Diesel Engine Gasoline Engine Natural Gas Electric Motor Hand Pfactor PTO Windmill Other (specify):
Pump Test Data Date Well Tested:	Method of Measuring Water Level Circle one Air Line Electric Measuring Line Steel Tape Other (specify):
This is for (circle one): New Wel Replacement of E: I HEREBY CERTIFY that the above statements are true to the best COMPANY ROLLO-711P Print Name of Pum Installer and License No. (if applicable)	

in in