

WASHINGTON

M 2001

MISSISSIPPI
BOARD OF WATER COMMISSIONERS
416 North State Street
Jackson, Mississippi 39201

WATER WELL DRILLERS LOG

22 Nov
date well completed

1977 Lambert Drilling
firm name

Wab
county well located

LANDOWNER:	description of formations encountered	from	to
Willie Gray Hollandale, Miss (mailing address)			
	sand	30	66
WELL LOCATION: sec 36 T 16 N R 6 E 5 miles E of Hollandale (distance) (direction) (nearest town)	sand gravel	65	92
	Clay	92	260
WELL PURPOSE: home (home, irrigation, municipal, industrial)	sand fine	260	340
WELL COMPLETION DATA:	sand med.	340	360
(1) diameter (inches) 2"			
(2) total depth (feet) 350			
(3) static water level (feet) 20 below top of ground			
(4) casing PVC 340 (material) (depth)			
2 If telescope see back. (size)			
(5) screen 10 350-340 (length) (depth to top)			
2 PVC (size) (material)			
(6) pump 1 9 (HP) (yield gpm)			
elect (type power)			
(7) electric log no (yes or no)			
(organization running log)			
(8) how well bottom plugged back wash			
DRILLERS REMARKS:			


RECEIVED

MAY 16 1978

MISS. BD. OF WATER COMM.

If well telescopes please sketch and show depths.

GROUND LEVEL

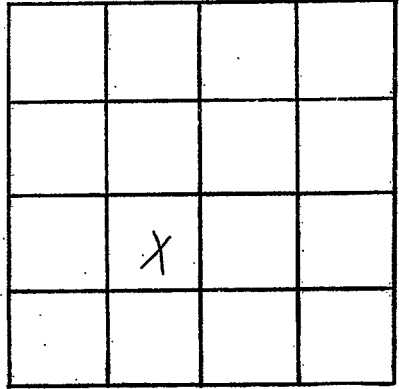

SECTION 36

Please indicate well location X.

ADDITIONAL INFORMATION

If more than one screen,
show locations of each on sketch.