

WASHINGTON

M

2000

4-18-78

MISSISSIPPI BOARD OF WATER COMMISSIONERS 416 North State Street Jackson, Mississippi 39201

WATER WELL DRILLERS LOG

April 18 1978 date well completed

Schultz Drilling Co firm name

Washington county well located

LANDOWNER: John Aldridge

Box 38

Aldridge

Hollendale MS

(mailing address)

description of formations encountered

from

to

Clay 0-20
FINE BROWN SAND 20-47
COARSE SAND 47-80
Red gravel

WELL LOCATION:

sec. 17 T. 16 N R. 6 E S 3 miles SE of Arcola (distance) (direction) (nearest town)

WELL PURPOSE: DOMESTIC (home, irrigation, municipal, industrial)

WELL COMPLETION DATA:

- (1) diameter (inches) 2 in
(2) total depth (feet) 80 ft
(3) static water level (feet) 17 below top of ground.
(4) casing PVC 75 ft (material) (depth)
(5) screen 5 ft 75 ft (length) (depth to top)
(6) pump (HP) (yield gpm)
(7) electric log NO (yes or no)
(8) how well bottom plugged plug


RECEIVED JUN 12 1978

DRILLERS REMARKS:

MISS. BD. OF WATER COMMISSIONERS

If well telescopes please sketch and show depths.

GROUND LEVEL

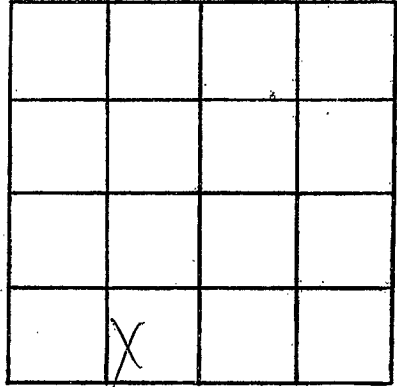

SECTION 17

Please indicate well location X.

ADDITIONAL INFORMATION

If more than one screen, show locations of each on sketch.