

WASHINGTON

M 2003

5-10-78

MISSISSIPPI BOARD OF WATER COMMISSIONERS 416 North State Street Jackson, Mississippi 39201

WATER WELL DRILLERS LOG

5-10 date well completed

1978 Schultz Drilling Co firm name

Washington county well located

LANDOWNER: Wm. Heinsson Hollandale MS

description of formations encountered

from to

(mailing address)

Clay 0 16  
fine sand 16 50  
COARSE SAND + pea gravel 50 75

WELL LOCATION:

sec. 30 T. 16 N. R. 5 E. 6 miles NE of Hollandale (distance) (direction) (nearest town)

WELL PURPOSE: HOME (home, irrigation, municipal, industrial)

WELL COMPLETION DATA:

- (1) diameter (inches) 2 in
(2) total depth (feet) 75 ft
(3) static water level (feet) 16 below top of ground.
(4) casing PVC 70 (material) (depth)
(5) screen 5 ft 70 ft (length) (depth to top)
(6) pump (HP) (yield gpm)
(7) electric log NO (yes or no)

(organization running log) how well bottom plugged


DRILLERS REMARKS:

RECEIVED JUN 12 1978

MISS. Bd. OF WATER COMMISSIONERS

If well telescopes please sketch and show depths.

GROUND LEVEL

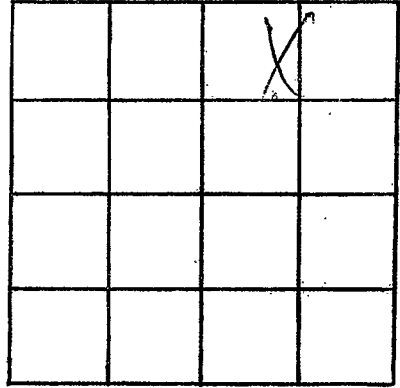

SECTION 30

Please indicate well location X.

ADDITIONAL INFORMATION

If more than one screen, show locations of each on sketch.