

Washington
M 2000
12-10-79

MISSISSIPPI
BOARD OF WATER COMMISSIONERS
416 North State Street
Jackson, Mississippi 39201

WATER WELL DRILLERS LOG

12-10 date well completed
1979 Larry's Well Pump firm name
Washington county well located

LANDOWNER: R. M. Pritchett

Arcola Miss.

(mailing address)

WELL LOCATION:

sec. 17 T. 16 N R. 5 W
3 miles East of Darlove
(distance) (direction) (nearest town)

WELL PURPOSE:
(home, irrigation, municipal, industrial)

WELL COMPLETION DATA: 105.4"

- (1) diameter (inches) 4" x 2"
- (2) total depth (feet) 508'
- (3) static water level (feet) 21' ~~below~~ ~~top~~ below top of ground.
- (4) casing steel, 488'
(material) (depth)

 if telescope see back.
(size)

- (5) screen 20', 488'
(length) (depth to top)
2", stainless steel
(size) (material)

- (6) pump 1 HP, 40 GPM
(HP) (yield gpm)
Electric
(type power)

- (7) electric log
(yes or no)

(organization running log)

- (8) how well bottom plugged High water

DRILLERS REMARKS:



description of formations encountered	from	to
Clay	0'	18'
2 1/2 fine sand	18'	35'
2 1/2 coarse sand	35'	80'
2 1/2 coarse sand / gravel	80'	130'
clay	130'	150'
clay + sand	150'	205'
sand	205'	340'
clay + sand	340'	450'
clay	450'	475'
sand	475'	508'

DEPT. OF NATURAL RESOURCES
BUREAU OF LAND & WATER RESOURCES

DEC 13 1979

RECEIVED

If well telescopes please sketch and show depths.

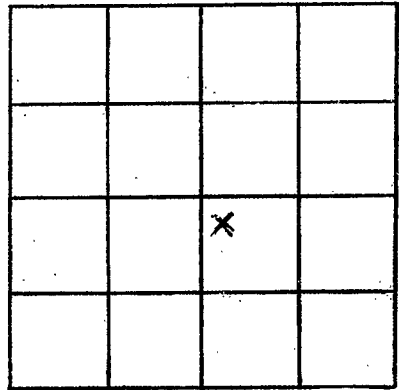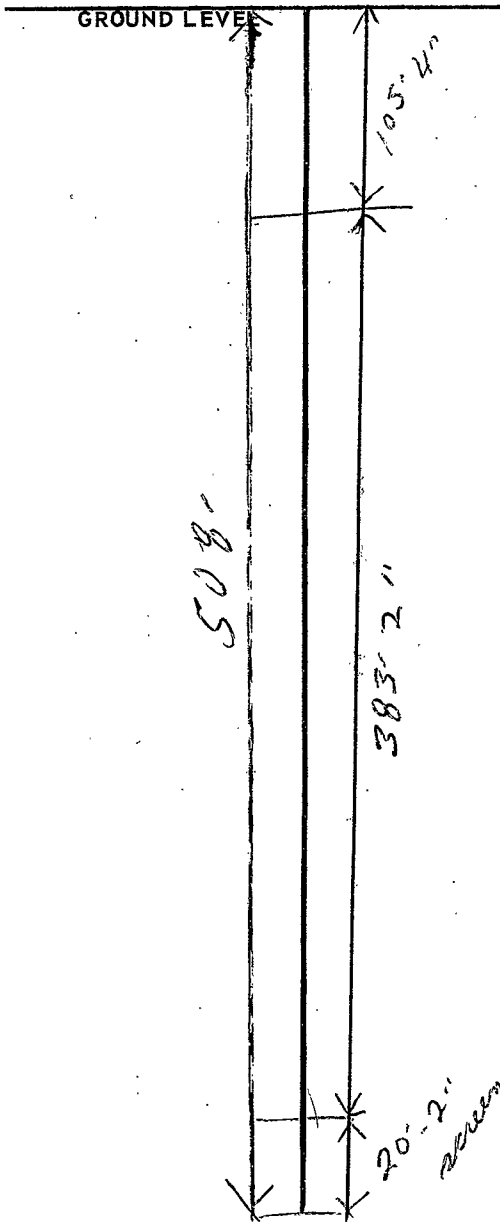

SECTION 17

Please indicate well location X.

ADDITIONAL INFORMATION

A series of horizontal lines for writing additional information, starting below the "ADDITIONAL INFORMATION" header and extending to the bottom of the page.

If more than one screen, show locations of each on sketch.